

SCHOOLCRAFT COUNTY
PEER GROUP APPROVED

SURVEY &
REMONUMENTATION

JAN 21 1998

DATE 11/12/97

LAND-CORNER RECORDATION CERTIFICATE
Filing Requirement of Act 74, Mich. P.A. 1970

SECTION

For corners in

Schoolcraft (County)	Located In:	Corner Code #
1. Public Land Survey	T42N R16W	J-5
	T R	
	T R	
	T R	
2. Property Controlling in Section	S T R	
	S T R	
3. Miscellaneous Property in Sec.	S T R	
	S T R	

Received & Filed this 23 day of
Dec 1997 at 3:11 P M
Sigrid I. Hedberg
Schoolcraft Co. Reg. of Deeds

Register of Deeds Stamp & File Number

4. Lot No. _____, Recorded Plat _____
5. Private Claims _____

I, Thomas P. O'Brien, in a field survey on Dec. 8, 1997 do hereby state that under requirements of P.A. 74, Michigan P.A. of 1970, the corner points mentioned in lines 1 and 2 above were in conformance with regulations and rules therefore as required in the current manual of survey instructions of the United States Department of the Interior, Bureau of Land Management or by a decree of a Court of Law and /or that the corner points mentioned in lines 3, 4 and 5 above were in conformance with the rules of the Michigan Board of Land Surveyors or by a Decree of a Court of Law, established, re-established, monumented, recovered, found as expressed below:

NOTE: Not more than 2 corners, all in the same town and range, may be recorded on this certificate.

	A	B	C	D	E	F	G	H	I	J	K	L	M
1													
2		6		5		4		3		2		1	
3													
4		7		8		9		10		11		12	
5										X			
6		18		17		16		15		14		13	
7													
8		19		20		21		22		23		24	
9													
10		30		29		28		27		26		25	
11													
12		31		32		33		34		35		36	
13													

A. Description of original monument and accessories and/or subsequent restoration:

J-5 North 1/4 Corner Section 14
Aug. 15, 1850 - Algernon Merryweather D.S. set qr. section post.
Spruce Pine 7 in. N43E 77 links Do. 8 in. S83E 87 links

1943 ± State proj. 75-40 (L-55-B-3) sheet 7, 1/4 corner 11 & 14 T42N - R16W.
3" Cedar post found 313 + 85.54. Lt. , 2493.24' W.of C/L M-94 , 2631.74 W. of
Tangent. B.T.'s S10°W 32.95' 4" Pine - N21°W 43.90' 4" Pine - N85°E 50.40' 6" Balsam


B. Description of corner evidence found and/or method applied in restoring or reestablishing corner:

J-5 Dec. 8, 1997 - Thomas P. O'Brien P.S. recovered a 3" squared post with 2 B.T.'s
4" J. Pine (Dead) S10°W - 33.95' 4" J. Pine (Dead) N21°W - 43.90'. Witnesses
found verify corner location as noted in State project 75-40. Reset post with
Schoolcraft County Monument.

C. Description of monument for corner and accessories established to perpetuate locating the position of the corner:

J-5 Schoolcraft County Monument stamped to identify.

Witnesses: 8" W. Pine - N42°E - 52.13'
6" Tamarack- S29°E - 53.25'
6" Tamarack- S55°W - 87.94'
4" Tamarack- N45°W - 110.25'
Carsonite Post - North - 2.0'

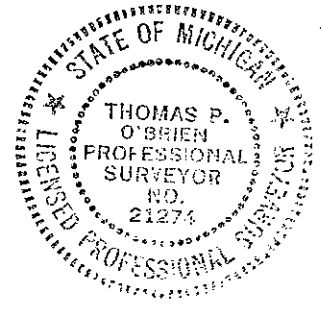

Thomas P. O'Brien

Signed by Thomas P. O'Brien P.S.
Surveyor's Michigan License No. 21274

Date December 19, 1997

LIBER 4 PAGE: 157