

JAN 21 1998

SCHOOLCRAFT COUNTY  
PEER GROUP APPROVED

DATE 10/15/97

LAND CORNER RECORDATION CERTIFICATE  
Filing Requirement of Act 74, Mich. P.A. 1970

SECTION

For corners in

Schoolcraft (County)	Located in:	Corner Code #
1. Public Land Survey	T42NR16W	J-9
	T R	
	T R	
	T R	
2. Property Controlling in Section	S T R	
	S T R	
3. Miscellaneous Property in Sec.	S T R	
	S T R	

Received & Filed this 23 day of  
Dec 1997 at 3:05 P M  
Sigrid I. Hedberg  
Schoolcraft Co. Reg. of Deeds

Register of Deeds Stamp & File Number

4. Lot No. \_\_\_\_\_, Recorded Plat \_\_\_\_\_  
5. Private Claims \_\_\_\_\_

I, Thomas P. O'Brien in a field survey on Nov. 5, 1997 do hereby state that under requirements of P.A. 74, Michigan P.A. of 1970, the corner points mentioned in lines 1 and 2 above were in conformance with regulations and rules therefore as required in the current manual of survey instructions of the United States Department of the Interior, Bureau of Land Management or by a decree of a Court of Law and /or that the corner points mentioned in lines 3, 4 and 5 above were in conformance with the rules of the Michigan Board of Land Surveyors or by a Decree of a Court of Law; established, re-established, monumented, recovered, found as expressed below:

NOTE: Not more than 2 corners, all in the same town and range, may be recorded on this certificate.

	A	B	C	D	E	F	G	H	I	J	K	L	M
1													
2	6	5	4	3	2	1							
3													
4	7	8	9	10	11	12							
5													
6	18	17	16	15	14	13							
7													
8	19	20	21	22	23	24							
9													
10	30	29	28	27	26	25							
11													
12	31	32	33	34	35	36							
13													

A. Description of original monument and accessories and/or subsequent restoration:

J-9 N 1/4 Corner Section 26  
Aug. 13, 1850 - Algernon Merryweather D.S. set qr. section post.  
Sugar 7 in. N49E 14 lks. do. 18 in. S63W 12 lks.

Sept. 19, 1985 - Neil E. Hill R.L.S. "found 1/2" Re-rod in Monument Box at location of record, set witnesses and temporary reference monuments prior to road construction. Found 1/2" Re-rod in monument box undisturbed below new road surface, Sept. 6, 1988." LCRC recorded Liber 2, page 200.


B. Description of corner evidence found and/or method applied in restoring or reestablishing corner:

J-9 Nov. 5, 1997 - Thomas P. O'Brien P.S. recovered a 1/2" iron bar with cap # 27447 in monument box. Witnesses found verify corner location.

C. Description of monument for corner and accessories established to perpetuate locating the position of the corner:

J-9 1/2" Iron bar with cap # 27447 in monument box.

Witnesses: (Fd.) Power Pole - N55°E - 45.17'  
(Fd.) 15" Y. Birch - S40°E - 89.24'  
(Fd.) Con. Monument - S20°W - 95.65'  
NBT 28" Maple - N15°W - 134.72'

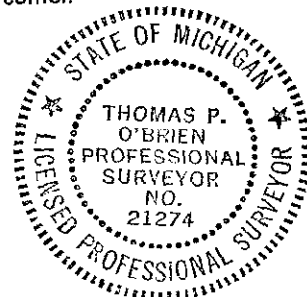

Signed by Thomas P. O'Brien P.S.  
Surveyor's Michigan License No. 21274

Date November 28, 1997

LIBER 4 PAGE: 154