

**SCHOOLCRAFT COUNTY
PEER GROUP APPROVED**

**SURVEY &
REMONUMENTATION**

DATE 11/12/97

**LAND CORNER RECORDATION CERTIFICATE
Filing Requirement of Act 74, Mich. P.A. 1970**

JAN 21 1998

For corners in

Schoolcraft _____ Located in: _____ Corner Code # _____
(County)

- 1. Public Land Survey T42NR16W K-1 ✓
T43NR16W K-13
T___R___
T___R___
- 2. Property Controlling S___T___R___
in Section S___T___R___
- 3. Miscellaneous S___T___R___
Property in Sec. S___T___R___

SECTION
Received & Filed this 9 day of
Dec. 1997 at 4:04 PM
Sigrid I. Hedberg
Schoolcraft Co. Reg. of Deeds
Register of Deeds Stamp & File Number

- 4. Lot No. _____, Recorded Plat _____
- 5. Private Claims _____

Thomas P. O'Brien, in a field survey on Nov. 24, 1997 do hereby state that under requirements of P.A. 74, Michigan P.A. of 1970, the corner points mentioned in lines 1 and 2 above were in conformance with regulations and rules therefore as required in the current manual of survey instructions of the United States Department of the Interior, Bureau of Land Management or by a decree of a Court of Law and/or that the corner points mentioned in lines 3, 4 and 5 above were in conformance with the rules of the Michigan Board of Land Surveyors or by a Decree of a Court of Law, established, re-established, monumented, recovered, found as expressed below:

1	A	B	C	D	E	F	G	H	I	J	K	L	M
2		6		5		4		3		2		1	
3													
4		7		8		9		10		11		12	
5													
6		18		17		16		15		14		13	
7													
8		19		20		21		22		23		24	
9													
10		30		29		28		27		26		25	
11													
12		31		32		33		34		35		36	
13													

NOTE: Not more than 2 corners, all in the same town and range, may be recorded on this certificate.

A. Description of original monument and accessories and/or subsequent restoration:


- K-1 NE Corner Section 2
June 3, 1841 - William A Burt D.S. set corner post.
Hemlock 12 N32E 19 do 18 N35W 21
August 10, 1850 - Algernon Merryweather D.S. corner 1&2 North Boundry.
Soft Maple 8 S41W 27 lks. Hemlock 18 S68E 33 lks.
July 22, 1969 - Frank J. Bray R.L.S. set corner " on line and the single proportioned measurement between the town corner one mile to the East and 1/4 corner 1/2 mile to the West." LCRC recoded Liber 3, page 174.

B. Description of corner evidence found and/or method applied in restoring or reestablishing corner:

- K-1 Nov. 24, 1997 - Thomas P. O'Brien P.S. recovered a 1/2" iron bar w/cap 27447 set in a monument box in the centerline of M-94. Witnesses found verify corner location as set by Frank J. Bray on July 22, 1969.

C. Description of monument for corner and accessories established to perpetuate locating the position of the corner:

- K-1 1/2" iron bar with cap #27447 in monument box.
Witnesses: (Fd.) 17" R. Pine-S38°E - 89 lks. (Fd. M.D.O.T. tag 59.15')
(Fd.) 16" R. Pine-N46°E - 138 " (Fd. M.D.O.T. tag 91.55')
NBT. 18" W. Pine-S51°W - 120.20'
NBT. 10" W. Pine-N38°W - 80.40'
Carsonite Post -N86°W - 40.00'

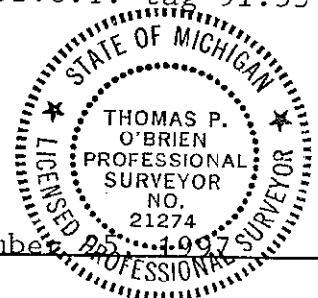

Signed by Thomas P. O'Brien P.S.
Surveyor's Michigan License No. 21274

Date November 25, 1997