

**SCHOOLCRAFT COUNTY
PEER GROUP APPROVED**

**SURVEY &
REMONUMENTATION**

DATE 10/15/97

LAND CORNER RECORDATION CERTIFICATE
Filing Requirement of Act 74, Mich. P.A. 1970

JAN 21 1998

For corners in

<u>Schoolcraft</u> (County)	Located In:	Corner Code #
1. Public Land Survey	T42NR16W	L-7
	T___R___	_____
	T___R___	_____
	T___R___	_____
2. Property Controlling in Section	S___T___R___	_____
	S___T___R___	_____
3. Miscellaneous Property in Sec.	S___T___R___	_____
	S___T___R___	_____

SECTION

Received & Filed this 9 day of
December 1997 at 3:53 P.M.
Sigrid I. Hedberg
Schoolcraft Co. Reg. of Deeds

Register of Deeds Stamp & File Number

4. Lot No. _____, Recorded Plat _____
5. Private Claims _____

Thomas P. O'Brien, in a field survey on Nov. 7, 1997 do hereby state that under requirements of P.A. 74, Michigan P.A. of 1970, the corner points mentioned in lines 1 and 2 above were in conformance with regulations and rules therefore as required in the current manual of survey instructions of the United States Department of the Interior, Bureau of Land Management or by a decree of a Court of Law and/or that the corner points mentioned in lines 3, 4 and 5 above were in conformance with the rules of the Michigan Board of Land Surveyors or by a Decree of a Court of Law; established, re-established, monumented, recovered, found as expressed below:

NOTE: Not more than 2 corners, all in the same town and range, may be recorded on this certificate.

1	A	B	C	D	E	F	G	H	I	J	K	L	M
2		6		5		4		3		2		1	
3													
4		7		8		9		10		11		12	
5													
6		18		17		16		15		14		13	
7													X
8		19		20		21		22		23		24	
9													
10		30		29		28		27		26		25	
11													
12		31		32		33		34		35		36	
13													

A. Description of original monument and accessories and/or subsequent restoration:

L-7 N 1/4 Corner Section 24
Aug. 9, 1850 - Algernon Merryweather D.S. set qr. section post.
Spruce 8 N25W 35 lks. Spruce 6 S16E 19 lks.

Oct. 8, 1987 - Gerald L. Wiggins L.S. set corner "at found squared and scribed post. Post matches a Carl Christenson post set at the N.E. Corner of Section 24 where he found original B.T.'s." LCRC recoded Liber 2, page 114.


B. Description of corner evidence found and/or method applied in restoring or reestablishing corner:

L-7 Nov. 7, 1997 - Thomas P. O'Brien P.S. recovered a 1" iron pipe with 4" aluminum cap as set by Gerald L. Wiggins on October 8, 1987. Witnesses found verify corner location.

C. Description of monument for corner and accessories established to perpetuate locating the position of the corner:

L-7 1" iron pipe with 4" aluminum DNR cap stamped to identify.

Witnesses: (Fd.) 4" Spruce - S25°E - 21.0'
(Fd.) 3" Spruce - S17°W - 51.6' (Dead)
NBT. 6" Spruce - N88°E - 45.73'
NBT. 3" Tamarack - S60°W - 53.98'
NBT. 3" Tamarack - N61°W - 54.31'
(Fd.) 6" Cedar Post - N45°W - 1.0'

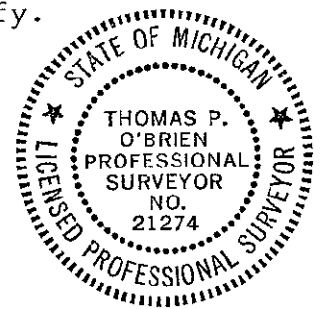

Signed by Thomas P. O'Brien P.S.
Surveyor's Michigan License No. 21274

Date November 26, 1997

LIBER 4 PAGE: 134