

OCT 26 1995

COMMISSION

SCHOOLCRAFT COUNTY PEER GROUP APPROVED

DATE March 10, 1995 LAND CORNER RECORDATION CERTIFICATE

Filing Requirement of Act 74, Mich. P.A. 1970

For corners in Schoolcraft
(County)

Located In: _____ Corner Code # _____

1. Public Land Survey	T	42N	R	15W	A-2
	T	42N	R	16W	M-2 ✓
	T	_____	R	_____	_____
	T	_____	R	_____	_____
2. Property Controlling in Section	S	_____	T	_____	_____
	S	_____	T	_____	_____
3. Miscellaneous Property in Sec.	S	_____	T	_____	_____
	S	_____	T	_____	_____

Received & Filed this 10 day of March 1995 at 2:39 pM
Sigrid I. Hedberg
Schoolcraft Co. Reg. of Deeds

Register of Deeds Stamp & File Number

- 4. Lot No. _____, Recorded Plat _____
- 5. Private Claims _____


I, Thomas P. O'Brien, in a field survey on Nov. 30, 1993, do hereby certify that under requirements of P.A. 74, Michigan P.A. of 1970, the corner points mentioned in lines 1 and 2 above were in conformance with regulations and rules therefore as required in the current manual of survey instructions of the United States Department of the Interior, Bureau of Land Management or by a decree of a Court of Law and/or that the corner points mentioned in lines 3, 4 and 5 above were in conformance with the rules of the Michigan Board of Land Surveyors or by a Decree of a Court of Law; established, re-established, monumented, re-monumented, recovered, found as expressed below:

NOTE: Not more than 4 corners, all in the same town and range, may be recorded on this certificate.

A. Description of original monument and accessories and/or subsequent restoration:
A-2 (West 1/4 Corner Sec. 6)
Aug. 4, 1845 John Burt, D.S. set qr. section post.
Yellow Pine 5 N60W 23 White Pine 26 S56W 24

B. Description of corner evidence found and/or method applied in restoring or reestablishing corner:
A-2 Oct. 16, 1967 - Frank J. Bray, RLS placed the corner on line and the single proportioned measurement between section corner to south and town corner to north. Wood post near checks with stump bottom to SW but no evidence of stump to NW.
July 9, 1979 - David B. Babbitt, RLS recovered D.N.R. monument set by F. Bray. Bray witnesses had been cut. Babbitt rewitnessed the corner.
Nov. 30, 1993 - Thomas P. O'Brien, PS recovered D.N.R. monument set by F. Bray. Babbitt witness 17" Red Pine S58W 73.1' cut.

C. Description of monument for corner and accessories established to perpetuate locating the position of the corner:
A-2 1" pipe w/4" aluminum cap stamped to identify.
14" Red Pine S1E 58.9'
14" Red Pine N88W 86.7'
10" Oak S85E 83.2'
(Witnesses established by David B. Babbitt on July 9, 1979 and recorded on LCRC in Liber 1, Page 266. trees tagged and corner posted this date.)

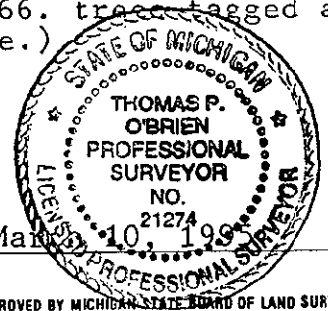

Signed by Thomas P. O'Brien Date March 10, 1995
Surveyor's Michigan License No. 21274

LIBER 2 PAGE: 390