

LAND CORNER RECORDATION CERTIFICATE
Filing Requirement of Act 74, Mich. P.A. 1970

For corners in


Schoolcraft

(County)

Located In:

Corner Code #

- | | | |
|------------------------------------|---------------------------------------|------------|
| 1. Public Land Survey | T <u>42N</u> R <u>17W</u> | <u>110</u> |
| | T _____ R _____ | _____ |
| | T _____ R _____ | _____ |
| | T _____ R _____ | _____ |
| 2. Property Controlling in Section | S <u>27</u> T <u>42N</u> R <u>17W</u> | <u>14</u> |
| | S _____ T _____ R _____ | _____ |
| 3. Miscellaneous Property in Sec. | S _____ T _____ R _____ | _____ |
| | S _____ T _____ R _____ | _____ |

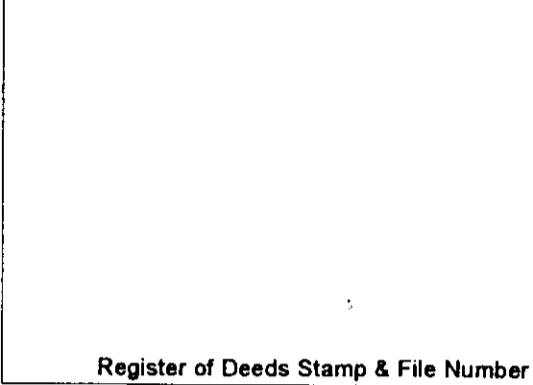

4. Lot No. _____, Recorded Plat _____
 5. Private Claims _____

Jun 02 2003

I, Stephan J. Szyszkoski, in a field survey on _____, 20____ do hereby state that under requirements of P.A. 74, Michigan P.A. of 1970, the corner points mentioned in lines 1 and 2 above were in conformance with regulations and rules therefore as required in the current manual of survey instructions of the United States Department of the Interior, Bureau of Land Management or by a decree of a Court of Law and /or that the corner points mentioned in lines 3, 4 and 5 above were in conformance with the rules of the Michigan Board of Land Surveyors or by a Decree of a Court of Law; established, re-established, monumented, recovered, found as expressed below:

NOTE: Not more than 2 corners, all in the same town and range, may be recorded on this certificate.

1	A	B	C	D	E	F	G	H	I	J	K	L	M
2		6		5		4		3		2		1	
3													
4		7		8		9		10		11		12	
5													
6		18		17		16		15		14		13	
7													
8		19		20		21		22		23		24	
9													
10		30		29		28		27	●	26		25	
11									●				
12		31		32		33		34		35		36	
13													

A. Description of original monument and accessories and/or subsequent restoration:
 (I10) Quarter corner common to Sections 26 & 27. 1850: Established by A.Merryweather on line between Section corners 39.91 chains north and south. Set post. Sugar 10 S40W 36 links, Hemlock 14 N50E 12 links.
 (14-Sec. 27) South 1/16 corner between Sections 26 & 27. Not established in the original survey.

B. Description of corner evidence found and/or method applied in restoring or reestablishing corner:
 (I10) The original post and accessories were not recovered. Found no acceptable evidence of the position of the original corner on the ground. Reestablished the corner midway and on a straight line between Section corners 2631.80 ft. north and south.
 (14-Sec. 27) Established the corner midway and on a straight line between Quarter and Section corners 1315.90' north and south.

C. Description of monument for corner and accessories established to perpetuate locating the position of the corner:

(I10) Set 1"IDx36" I.pipe with 4" alum. MDNR cap. Blazed, scribed, and set measuring nails in:	(14) Set 1"IDx36" I.pipe with 4" alum. MDNR cap. Blazed, scribed, and set measuring nails in:
10" R.Pine N55W 5.9' "1/4S N8T"	18" Maple N75W 4.8' "S1/16 BT"
12" R.Pine S52E 14.1' do	8" Y.Birch N23W 5.55' do
10" R.Pine S24W 14.75' do	18" Maple S50E 18.3' do
12" R.Pine N32E 21.2' do	16" Maple S45W 33.3' do
Set Cedar post adjacent. Bearings are magnetic. Distances are to nail with tag.	Bearings are magnetic. Distances are to nail with tag.



Signed by Stephan J. Szyszkoski
 Surveyor's Michigan License No. 33986

Date 6/19/03