

LAND CORNER RECORDATION CERTIFICATE
Filing Requirement of Act 74, Mich. P.A. 1970

For corners in

Schoecraft
 (County)

Located in:

Corner Code #

1. Public Land Survey	T	R	
	T	R	
	T	R	
	T	R	
2. Property Controlling in Section	S 27	T 42N	R 17W
	S 27	T 42N	R 17W
3. Miscellaneous Property in Sec.	S	T	R

4. Lot No. _____, Recorded Plat _____

5. Private Claims _____

10 Jun 02 2003
 12 May 29 2003

1. Stephan J. Szyzkoski, in a field survey on _____, 20 _____ do hereby state that under requirements of P.A. 74, Michigan P.A. of 1970, the corner points mentioned in lines 1 and 2 above were in conformance with regulations and rules therefore as required in the current manual of survey instructions of the United States Department of the Interior, Bureau of Land Management or by a decree of a Court of Law and/or that the corner points mentioned in lines 3, 4 and 5 above were in conformance with the rules of the Michigan Board of Land Surveyors or by a Decree of a Court of Law, established, re-established, monumented, recovered, found as expressed below:


NOTE: Not more than 2 corners, all in the same town and range, may be recorded on this certificate.

1	A	B	C	D	E	F	G	H	I	J	K	L	M
2	6	5	4	3	2	1							
3													
4	7	8	9	10	11	12							
5													
6	18	17	16	15	14	13							
7													
8	19	20	21	22	23	24							
9													
10	30	29	28	27	26	25							
11													
12	31	32	33	34	35	36							
13													

A. Description of original monument and accessories and/or subsequent restoration:
 (12-Sec. 27) South 1/16 corner, Section 27. Not established in the original survey.
 (10-Sec. 27) South 1/16 corner between Sections 27 & 28. Not established in the original survey.

B. Description of corner evidence found and/or method applied in restoring or reestablishing corner:
 (12-Sec. 27) Established the corner midway and on a straight line between center of Section and Quarter corner 1312.57' north and south.
 (10-Sec. 27) Established the corner midway and on a straight line between Quarter and Section corners 1309.14' north and south. The corner falls on the west edge of a trail.

C. Description of monument for corner and accessories established to perpetuate locating the position of the corner:
 (12) Set 1"10x36" I. pipe with 4" alum. HDNR cap, blazed, scribed, and set measuring nails in:
 12" Maple M66E 9.75' "S1/16 87"
 10" Maple N28W 22.15' do
 8" Maple N31E 13.4' do
 14" Maple S35E 33.8' do
 An old E-W fence is 1 ft. south. Bearings are magnetic. Distances are to nail with tag.
 Signed by Stephan J. Szyzkoski Date 6/19/03
 Surveyor's Michigan License No. 33986

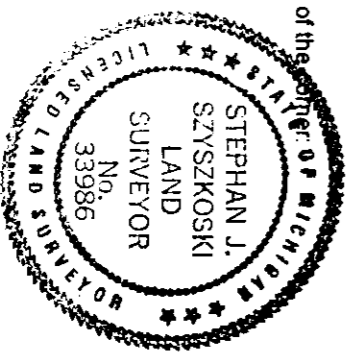

Register of Deeds Stamp & File Number