

LAND CORNER RECORDATION CERTIFICATE
Filing Requirement of Act 74, Mich. P.A. 1970

For corners in

Schoolcraft

(County)

Located in:

Corner Code #


1. Public Land Survey	T 42N R 17W	110
	T R	
	T R	
	T R	
2. Property Controlling in Section	S 27	14
	T R	
	T R	
3. Miscellaneous Property in Sec.	S	
	T R	

4. Lot No. _____, Recorded Plat _____
 5. Private Claims _____

Jun 02 2003

I, Stephan J. Szyzkoski, in a field survey on 20 do hereby state that under requirements of P.A. 74, Michigan P.A. of 1970, the corner points mentioned in lines 1 and 2 above were in conformance with regulations and rules therefore as required in the current manual of survey instructions of the United States Department of the Interior, Bureau of Land Management or by a decree of a Court of Law and/or that the corner points mentioned in lines 3, 4 and 5 above were in conformance with the rules of the Michigan Board of Land Surveyors or by a Decree of a Court of Law, established, re-established, monumented, recovered, found as expressed below:

NOTE: Not more than 2 corners, all in the same town and range, may be recorded on this certificate.

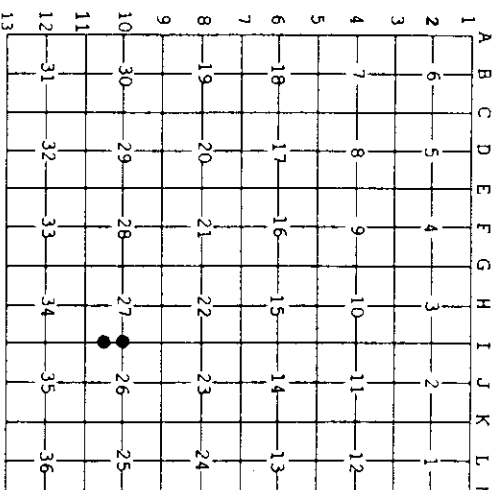

A. Description of original monument and accessories and/or subsequent restoration:

(110) Quarter corner common to Sections 26 & 27. 1850: Established by A.Merryweather on line between Section corner corners 39.91 chains north and south. Set post. Sugar 10 S40W 36 links, Hemlock 14 N50E 12 links.

(14-Sec. 27) South 1/16 corner between Sections 26 & 27. Not established in the original survey.


B. Description of corner evidence found and/or method applied in restoring or reestablishing corner:

(110) The original post and accessories were not recovered. Found no acceptable evidence of the position of the original corner on the ground. Reestablished the corner midway and on a straight line between Section corners 2631.80 ft. north and south.

(14-Sec. 27) Established the corner midway and on a straight line between Quarter and Section corners 1315.90' north and south.

C. Description of monument for corner and accessories established to perpetuate locating the position of the corner:

- | | |
|--|---|
| (110) Set 1"IDx36" I.pipe with 4" alum. MONR cap. Blazed, scribed, and set measuring nails in: | (14) Set 1"IDx36" I.pipe with 4" alum. MONR cap. Blazed, scribed, and set measuring nails in: |
| 10" R.pine N55W 5.9' | 18" Maple N75W 4.8' |
| 12" R.pine S52E 14.1' | 8" Y. Birch N23W 5.55' |
| 10" R.pine S24W 14.75' | 18" Maple S50E 18.3' |
| 12" R.pine N32E 21.2' | 16" Maple S45W 33.3' |
- Set Cedar post adjacent. Bearings are magnetic. Distances are to nail with tag.

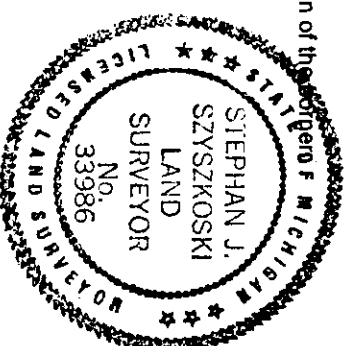

Signed by Stephan J. Szyzkoski
 Surveyor's Michigan License No. 33986

Date 6/19/03

For the Michigan Department of Natural Resources - Office of Land and Facilities

FORM APPROVED BY MICHIGAN STATE BOARD OF PROFESSIONAL SURVEYORS, JAN. 28, 1971

REVISED MAY 14, 1975
 REVISED JAN. 1983
 REVISED OCT., 1995