

LAND CORNER RECORDATION CERTIFICATE
Filing Requirement of Act 74, Mich. P.A. 1970

For corners in _____

Schoolcraft _____

(County)

Located in: _____

Corner Code # _____


1. Public Land Survey	T 42N R 17W	H9
	T 42N R 17W	19
	T ___ R ___	_____
	T ___ R ___	_____
	T ___ R ___	_____
2. Property Controlling in Section	S ___	T ___ R ___
	S ___	T ___ R ___
3. Miscellaneous Property in Sec.	S ___	T ___ R ___

4. Lot No. _____, Recorded Plat _____
 5. Private Claims _____

May 22 2003

I, Stephan J. Szyzskoski, in a field survey on _____, 20____ do hereby state that under requirements of P. A. 74, Michigan P. A. of 1970, the corner points mentioned in lines 1 and 2 above were in conformance with regulations and rules therefore as required in the current manual of survey instructions of the United States Department of the Interior, Bureau of Land Management or by a decree of a Court of Law and/or that the corner points mentioned in lines 3, 4 and 5 above were in conformance with the rules of the Michigan Board of Land Surveyors or by a Decree of a Court of Law, established, re-established, monumented, recovered, found as expressed below:

NOTE: Not more than 2 corners, all in the same town and range, may be recorded on this certificate.

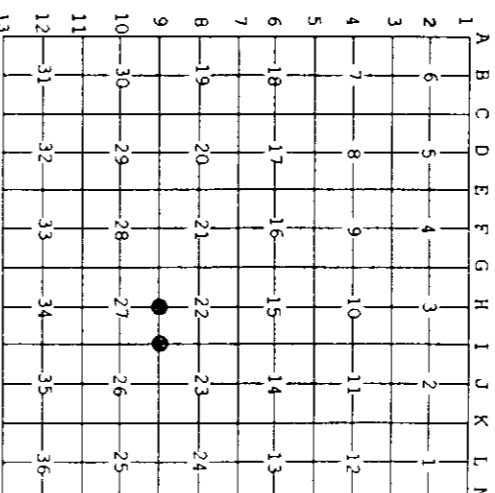


A. Description of original monument and accessories and/or subsequent restoration:
 (H9) Quarter corner common to Sections 22 & 27, 1850. Established by A. Herryweather on line between Section corners 40.00 chains east and west. Set post. Sugar 12 NS0W 9 links, Hemlock 14 S50E 31 links. Found no subsequent record.
 (19) Corner common to Sections 22-23-26-27, 1850. Established by A. Herryweather. Hemlock 18 N15E 11 links, Birch 18 S14W 49 links.

B. Description of corner evidence found and/or method applied in restoring or reestablishing corner:

(H9) The original post and accessories were not recovered. Found no acceptable evidence of the position of the original corner on the ground. Reestablished the corner midway and on a line of mean true bearing between Section corners 2657.59 ft. east and west. From the corner monumented, found a squared wood post staped " P/90 11-39 5" S19W (magnetic) 30.3' distant.
 (19) The original post and accessories were not recovered. Reestablished the corner by double proportionate measurement to the original record between Section corners 5263.61' North and South (79.82 chains GLO), Section corner 5323.77' East (80.13 ch. GLO), and Section corner 5315.19' West (80.00 ch. GLO). From the corner thus established, I found a wood post, placed by persons unknown, N58E 58' distant.

C. Description of monument for corner and accessories established to perpetuate locating the position of the corner:

(H9) Set 1"10X36" I. pipe with 4" alum. MONR cap. Blazed, scribed, and set	(19) Set 1"10X36" I. pipe with 4" alum. MONR cap. Blazed, scribed, and set
measuring nails in:	measuring nails in:
12" R. Pine S35W 26.7'	8" twin Maple N85W 13.45'
8" R. Pine N79W 7.75'	14" Maple N49W 25.95'
do	do
10" Maple N40E 30.85'	5" Maple N48E 34.8'
do	do
8" R. Pine S83E 30.2'	7" Maple S04E 22.45'
Bearings are Magnetic. Distances are to nail with tag. Set Cedar post adjacent.	Bearings are Magnetic. Distances are to nail with tag. Set cedar post adjacent.

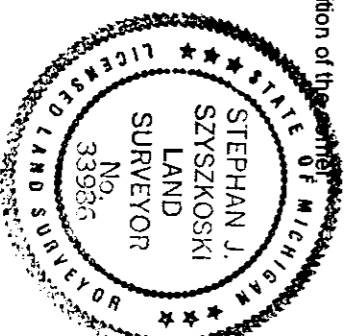

Signed by Stephan J. Szyzskoski Date 6/19/03
 Surveyor's Michigan License No. 33986

Register of Deeds Stamp & File Number _____