

**SCHOOLCRAFT COUNTY
PEER GROUP APPROVED**

**SURVEY &
REMONUMENTATION**

FEB 08 2001

DATE 10/10/00 DPB

**LAND CORNER RECORDATION CERTIFICATE
Filing Requirement of Act 74, Mich. P.A. 1970**

SECTION

For corners in

<u>Schoolcraft</u> (County)	Located In:	Corner Code #
1. Public Land Survey	T <u>42N</u> R <u>14W</u>	<u>J1</u>
	T <u>43N</u> R <u>14W</u>	<u>J13</u> ✓
	T ___ R ___	___
	T ___ R ___	___
2. Property Controlling in Section	S ___ T ___ R ___	___
	S ___ T ___ R ___	___
3. Miscellaneous Property in Sec.	S ___ T ___ R ___	___
	S ___ T ___ R ___	___

SIGRID HEDBERG 1P
SCHOOLCRAFT CO. REGISTER
Page 1 of 1 LC 4/376
JLV Date 12/19/2000 Time 11:53:21

Register of Deeds Stamp & File Number

4. Lot No. _____, Recorded Plat _____
5. Private Claims _____

I, Thomas P. O'Brien, in a field survey on 10/9/00, do hereby state that under requirements of P.A. 74, Michigan P.A. of 1970, the corner points mentioned in lines 1 and 2 above were in conformance with regulations and rules therefore as required in the current manual of survey instructions of the United States Department of the Interior, Bureau of Land Management or by a decree of a Court of Law and /or that the corner points mentioned in lines 3, 4 and 5 above were in conformance with the rules of the Michigan Board of Land Surveyors or by a Decree of a Court of Law; established, re-established, monumented, recovered, found as expressed below:

NOTE: Not more than 2 corners, all in the same town and range, may be recorded on this certificate.

1	A	B	C	D	E	F	G	H	I	J	K	L	M
2		6		5		4		3		2		1	
3													
4		7		8		9		10		11		12	
5													
6		18		17		16		15		14		13	
7													
8		19		20		21		22		23		24	
9													
10		30		29		28		27		26		25	
11													
12		31		32		33		34		35		36	
13													

A. Description of original monument and accessories and/or subsequent restoration:

Oct. 20, 1850 Algernon Merryweather, DS set qr. section post Spruce 6 N42E 9 do 5 N32W 11


Sept. 15, 1961 Billy D. Buckler, RLS " This corner was placed midway and on line between section corners. No original evidence."

B. Description of corner evidence found and/or method applied in restoring or reestablishing corner:

Oct. 9, 2000 Thomas P. O'Brien, PS found Mich. Dept. of Cons. cap on pipe as set by Buckler and verified by witnesses and distances to corners E and W. Accepted corner as found.

C. Description of monument for corner and accessories established to perpetuate locating the position of the corner:

Michigan Department of Conservation cap on pipe.
Witnesses:
10" Cedar S50°W 10 links - existing Buckler BT
14" Cedar N18°E 14½ links- existing Buckler BT
8" Cedar N29°W 12.05'
6" Cedar S85°E 23.95'
Carsonite Post North 1.0'

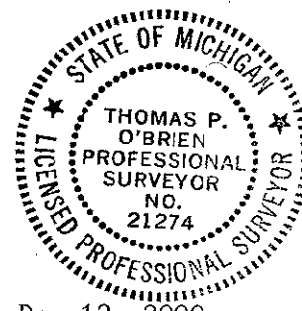

Signed by Thomas P. O'Brien
Surveyor's Michigan License No. 21274

Date Dec. 12, 2000

LIBER 4 PAGE: 376