

MICHIGAN
DEPARTMENT OF CONSERVATION
FORESTRY DIVISION

LAND CORNER RECORD

T. 43 N.R. 15W

Schoolcraft COUNTY


DESCRIPTION OF CORNER Section Corner for Sections 25-36 on East boundary of twp.

CORNER MONUMENT 1" Pipe with 4" Brass Cap.

DATE MONUMENT PLACED AND WITNESSED 5-23-61

WITNESSES TO CORNER..... 6" Jack Pine (S25 NBT) N17°W 06½ links

9" Jack Pine (S36 NBT) S48°W 16 links

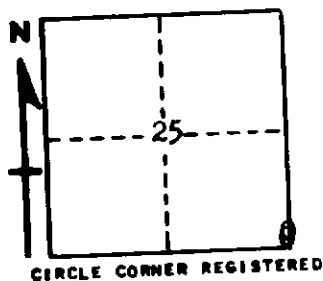

AND

DESCRIPTION IN DETAIL AS TO HOW CORNER WAS LOCATED AND IDENTIFIED OR RESTORED.

This corner was re-established by single proportionate measure along Township line.

Note: Corner lies on West bank of drainage ditch.

SURVEYOR'S SEAL

SIGNED Billy D. Buckler DATE December 29, 1961
REGISTERED LAND SURVEYOR
Billy D. Buckler