

STATE OF MICHIGAN
DEPARTMENT
OF
NATURAL RESOURCES
LAND CORNER RECORD

SCHOOLCRAFT COUNTY
T 43 N R 15 W

DESCRIPTION OF CORNER 1/4 corner for Sections 4/3


CORNER MONUMENT 1" iron pipe with 4" aluminum cap

DATE MONUMENT PLACED AND WITNESSED 4/6/72 F. J. Bray with M. Burnis

WITNESSES TO CORNER..... 18" W. Pine (1/8 S NBT) N65°E, 66.2'

9" W. Pine (1/8) (NBT) N04°E, 66.6'

AND

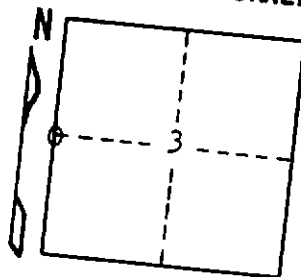

CIRCLE CORNER REGISTERED

DESCRIPTION IN DETAIL AS TO HOW CORNER WAS LOCATED AND IDENTIFIED OR RESTORED.

This corner was placed on line and the single proportioned measurement between the section corners to the north and to the south. No original evidence found.

SURVEYOR'S SEAL

DISTRIBUTION:

County Courthouse
Area Forester (Regions I & II)
District or Region Surveyor
Forestry Div., Lansing

SIGNED Frank J. Bray
REGISTERED LAND SURVEYOR
Frank J. Bray

DATE 5-12-72