

**SCHOOLCRAFT COUNTY  
PEER GROUP APPROVED**

**SURVEY &  
REMONUMENTATION**

**DATE** March 10, 1995 **LAND CORNER RECORDATION CERTIFICATE**  
**Filing Requirement of Act 74, Mich. P.A. 1970**

**OCT 26 1995**

For corners in  
Schoolcraft  
 (County)

Located In: Corner Code #

**COMMISSION**

Received & Filed this 10 day of  
March 1995 at 2:32 P.M.  
 Sigrid I. Hedberg  
 Schoolcraft Co. Reg. of Deeds

1. Public Land Survey	T 42N R 15W	A-1
	T 42N R 16W	M-1
	<u>T 43N R 15W</u>	<u>A-13</u> ✓
	T 43N R 16W	M-13
2. Property Controlling in Section	S ___ T ___ R ___	
	S ___ T ___ R ___	
3. Miscellaneous Property in Sec.	S ___ T ___ R ___	
	S ___ T ___ R ___	

Register of Deeds Stamp & File Number

4. Lot No. \_\_\_\_\_, Recorded Plat \_\_\_\_\_  
 5. Private Claims \_\_\_\_\_

	A	B	C	D	E	F	G	H	I	J	K	L
2	6	5	4	3	2							
3												
4	7	8	9	10	11	12						
5												
6	16	17	16	15	14	13						
7												
8	19	20	21	22	23	24						
9												
10	30	29	28	27	26	25						
11												
12	31	32	33	34	35	36						
13												

I, Thomas P.O'Brien in a field survey on Nov. 23, 1993, do hereby certify that under requirements of P.A. 74, Michigan P.A. of 1970, the corner points mentioned in lines 1 and 2 above were in conformance with regulations and rules therefore as required in the current manual of survey instructions of the United States Department of the Interior, Bureau of Land Management or by a decree of a Court of Law and/or that the corner points mentioned in lines 3, 4 and 5 above were in conformance with the rules of the Michigan Board of Land Surveyors or by a Decree of a Court of Law; established, re-established, monumented, re-monumented, recovered, found as expressed below:

**NOTE: Not more than 4 corners, all in the same town and range, may be recorded on this certificate.**

A. Description of original monument and accessories and/or subsequent restoration:

A-1(N.W. Corner Sec.6)  
 Oct. 25, 1841 - William A. Burt, D.S. set post corner of Townships 42 43 North between ranges 15 16W. Witnesses: Y. Pine 12 N53W 26  
 Do 14 S34E 14

B. Description of corner evidence found and/or method applied in restoring or reestablishing corner:

Oct, 16, 1967 - Frank J. Bray, RLS reestablished the corner position by double proportioned measurement between 1/4 corners 1 1/2 miles to west and 2 1/2 miles to East and between section corners 1 mile to north and to south. No original evidence found.

July 9, 1979 - David B. Babbitt rewitnesses D.N.R. monument set by F. Bray. Old witnesses cut.

Nov. 23, 1993 - Thomas P.O'Brien, P.S. recovered D.N.R. monument set by Frank J. Bray and rewitnesses by David B. Babbitt. Recovered witnesses by Babbitt verified monument position as set by Bray.


C. Description of monument for corner and accessories established to perpetuate locating the position of the corner:

1" pipe w/ 4" aluminum cap stamped to identify.

Witnesses:

- 12" Jack Pine N67W 78.0'
- 8" Red Pine S77W 9.4'
- 8" Red Pine S21W 27.5'
- 8" Red Pine S16E 20.1'

(Witnesses established by David B. Babbitt on July 9, 1979 and recorded on Liber 1, Page 266. Trees tagged and certified this date.)

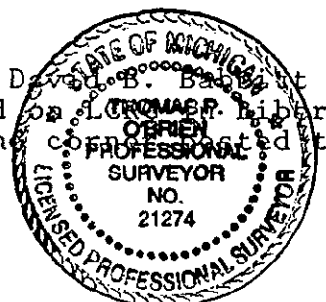

Signed by Thomas P.O'Brien, P.S. Date March 10, 1995

Surveyor's Michigan License No. 21274