

SCHOOLCRAFT COUNTY
PEER GROUP APPROVED

SURVEY &
MONUMENTATION

DATE March 10, 1995 0215 AND CORNER RECORDATION CERTIFICATE
Filing Requirement of Act 74, Mich. P.A. 1970

OCT 26 1995
COMMISSION

For corners in Schoolcraft (County) Located In: _____ Corner Code ##

1. Public Land Survey	T <u>42N</u> R <u>15W</u>	<u>F-1</u>
	T <u>43N</u> R <u>15W</u>	<u>F13</u> ✓
	T _____ R _____	_____
	T _____ R _____	_____
2. Property Controlling in Section	S _____ T _____ R _____	_____
	S _____ T _____ R _____	_____
3. Miscellaneous Property in Sec.	S _____ T _____ R _____	_____
	S _____ T _____ R _____	_____
4. Lot No. _____, Recorded Plat _____		
5. Private Claims _____		

Received & Filed this 10 day of March 1995 at 2:30 PM
Sigrid I. Hedberg
Schoolcraft Co. Reg. of Deeds

Register of Deeds Stamp & File Number

I, Thomas P.O'Brien in a field survey on Nov. 24, 1993, do hereby certify that under requirements of P.A. 74, Michigan P.A. of 1970, the corner points mentioned in lines 1 and 2 above were in conformance with regulations and rules therefore as required in the current manual of survey instructions of the United States Department of the Interior, Bureau of Land Management or by a decree of a Court of Law and/or that the corner points mentioned in lines 3, 4 and 5 above were in conformance with the rules of the Michigan Board of Land Surveyors or by a Decree of a Court of Law; established, re-established, monumented, re-monumented, recovered, found as expressed below:

	A	B	C	D	E	F	G	H	I	J	K	L	M
2	6	5	4	3	2	1							
3													
4	7	8	9	10	11	12							
5													
6	18	17	16	15	14	13							
7													
8	19	20	21	22	23	24							
9													
10	30	29	28	27	26	25							
11													
12	31	32	33	34	35	36							
13													


NOTE: Not more than 4 corners, all in the same town and range, may be recorded on this certificate.

A. Description of original monument and accessories and/or subsequent restoration:
F-1 (North 1/4 Corner Sec.4)
Oct.25, 1841 William A. Burt, D.S set qr. section post.
Beech 6 N23E 41 Birch 12 N60W 32

B. Description of corner evidence found and/or method applied in restoring or reestablishing corner:
F-1 Sept.17, 1964 - Arthur O. Enger. RLS recovered pipe set by Carl Christensen, presumably from original bearing trees or personal knowledge of corner's history. Road construction has destroyed any evidence of BT's. Corner seems to check well with natural features and other corners eastward along the township line.
Nov.24, 1993 - Thomas P.O'Brien, PS recovered Carl Christensen monument.

C. Description of monument for corner and accessories established to perpetuate locating the position of the corner:
F-1 2" iron pipe w/2 1/2" brass cap stamped "33-1/4-4, C.C."
16" Jack Pine N22 1/2W 96 1/2 links (63.69') Enger witness.
10" White Pine S65W 82 links (54.12') Enger witness.
6" Red Pine S89E 99.80' (NBT)
12" Maple S33W 49.65' (NBT)

Thomas P.O'Brien

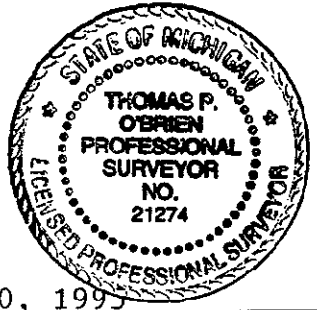

Signed by Thomas P.O'Brien, PS Date March 10, 1995
Surveyor's Michigan License No. 21274