

NOV 21 1996

COMMISSION

SCHOOLCRAFT COUNTY
PEER GROUP APPROVED

DATE 9/13/96 LAND CORNER RECORDATION CERTIFICATE
Filing Requirement of Act 74, Mich. P.A. 1970

For corners in

Schoolcraft
(County)

Located In:

Corner Code #

1. Public Land Survey

T42NR15W

H-1

T43NR15W

H-13

T R

T R

T R

2. Property Controlling
in Section

S

T R

S

T R

3. Miscellaneous
Property in Sec.

S

T R

S

T R

Received & Filed this 30 day of
Oct 1996 at 11:31 AM

Sigrid I. Hedberg
Schoolcraft Co. Reg. of Deeds

Register of Deeds Stamp & File Number

4. Lot No. _____, Recorded Plat _____
5. Private Claims _____

Thomas P. O'Brien in a field survey on Aug. 19, 1996 do hereby state that under requirements of P.A. 74, Michigan P.A. of 1970, the corner points mentioned in lines 1 and 2 above were in conformance with regulations and rules therefore as required in the current manual of survey instructions of the United States Department of the Interior, Bureau of Land Management or by a decree of a Court of Law and/or that the corner points mentioned in lines 3, 4 and 5 above were in conformance with the rules of the Michigan Board of Land Surveyors or by a Decree of a Court of Law; established, re-established, monumented, recovered, found as expressed below:

NOTE: Not more than 2 corners, all in the same town and range, may be recorded on this certificate.

	A	B	C	D	E	F	G	H	I	J	K	L	M
1													
2	6			5			4		3		2		1
3													
4	7			8			9		10		11		12
5													
6	18			17			16		15		14		13
7													
8	19			20			21		22		23		24
9													
10	30			29			28		27		26		25
11													
12	31			32			33		34		35		36
13													

A. Description of original monument and accessories and/or subsequent restoration:

H-1 (North 1/4 Corner Sec. 3)
May 30, 1841 William A Burt D.S. set qr. section post.
Tamarack 6 N27E 5 do. 6 N24W 8

B. Description of corner evidence found and/or method applied in restoring or reestablishing corner:


H-1 May 22, 1961- Billy D. Buckler, RLS set a 1" pipe with 4" brass cap.
" Corner was re-established midway and on line between two section corners."

Aug. 19, 1996- Thomas P. O'Brien P.S., recovered a 1" pipe with 4" brass cap as set by Billy D. Buckler on May 22, 1961.

C. Description of monument for corner and accessories established to perpetuate locating the position of the corner:

H-1 Found Mich. Dept. of Cons. 1' pipe with 4" brass cap stamped to identify.

Witnesses: Fd. 8" Cedar- N11°W - 35 lks. Ex. Cond.
Fd. 8" Cedar- N26°E - 37 lks. " "
10" Cedar- S68°W - 27.30' NBT
8" Cedar- S42°E - 8.42' NBT

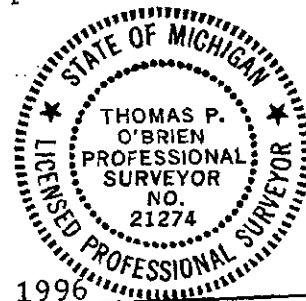

Signed by Thomas P. O'Brien
Surveyor's Michigan License No. 21274

Date August 19, 1996