

SCHOOLCRAFT COUNTY
PEER GROUP APPROVED

RECORDS SECTION

NOV 21 1996

COMMISSION

DATE 9/13/96 LAND CORNER RECORDATION CERTIFICATE
 Filing Requirement of Act 74, Mich. P.A. 1970

For corners in

Schoolcraft Located In: _____ Corner Code # _____
 (County)

- 1. Public Land Survey T42NR15W J-1
 T43NR15W J-13 ✓
 T___R___
 T___R___
- 2. Property Controlling S___T___R___
 in Section S___T___R___
- 3. Miscellaneous S___T___R___
 Property in Sec. S___T___R___

Received & Filed this 30 day of
Oct 1996 at 11:40 AM
 Sigrid I. Hedberg
 Schoolcraft Co. Reg. of Deeds

Register of Deeds Stamp & File Number

4. Lot No. _____, Recorded Plat _____
 5. Private Claims _____

I, Thomas P. O'Brien in a field survey on March 22 1996 do hereby state that under requirements of P.A. 74, Michigan P.A. of 1970, the corner points mentioned in lines 1 and 2 above were in conformance with regulations and rules therefore as required in the current manual of survey instructions of the United States Department of the Interior, Bureau of Land Management or by a decree of a Court of Law and /or that the corner points mentioned in lines 3, 4 and 5 above were in conformance with the rules of the Michigan Board of Land Surveyors or by a Decree of a Court of Law; established, re-established, monumented, recovered, found as expressed below:

1	A	B	C	D	E	F	G	H	I	J	K	L	M
2		6		5		4		3		2		1	
3													
4		7		8		9		10		11		12	
5													
6		18		17		16		15		14		13	
7													
8		19		20		21		22		23		24	
9													
10		30		29		28		27		26		25	
11													
12		31		32		33		34		35		36	
13													

NOTE: Not more than 2 corners, all in the same town and range, may be recorded on this certificate.

A. Description of original monument and accessories and/or subsequent restoration:

J-1 (North 1/4 Corner Sec. 2)
 May 30, 1841 William A. Burt D.S. set qr. section post.
 W. Pine 14 N49E.61 Spruce 8 N23W 6

B. Description of corner evidence found and/or method applied in restoring or reestablishing corner:


J-1 May 11, 1961- Billy D. Buckler, RLS set a 1" pipe with 4" brass cap.
 "Corner replaced from one W. Pine bearing N 49 deg. E, 61 lks."

March 22, 1996- Thomas P. O'Brien P.S., recovered a 1" pipe with 4" brass cap as set by Billy D. Buckler on May 11, 1961.

C. Description of monument for corner and accessories established to perpetuate locating the position of the corner:

J-1 Found Mich. Dept. of Cons. 1" pipe with 4" brass cap stamped 1/4
 $\frac{32}{5}$ restamped corner correctly $\frac{35}{2}$.

Witnesses: Fd. 18" Red Pine- S42°W - 29.85' Ex. Cond.
 10" Red Pine- N77°E - 46.44' NBT
 8" Red Pine- S60°E - 70.98' NBT
 10" Red Pine- N62°W - 38.43' NBT
 4" Cedar Post - North - 1.5'

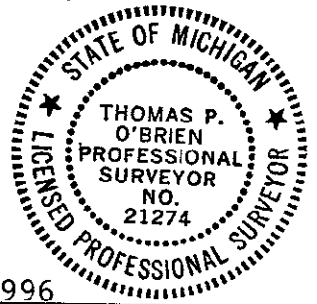

Signed by Thomas P. O'Brien

Date March 22, 1996

Surveyor's Michigan License No. 21274