

**SCHOOLCRAFT COUNTY  
PEER GROUP APPROVED**

DATE 9/13/96 *oob*

**LAND CORNER RECORDATION CERTIFICATE  
Filing Requirement of Act 74, Mich. P.A. 1970**

REMONUMENTATION

NOV 21 1996

COMMISSION

For corners in

<u>Schoolcraft</u> (County)	Located In:	Corner Code #
1. Public Land Survey	T42NR15W T43NR15W T___R___ T___R___	K-1 K-13
2. Property Controlling in Section	S___T___R___ S___T___R___	_____ _____
3. Miscellaneous Property in Sec.	S___T___R___ S___T___R___	_____ _____

Received & Filed this 30 day of Oct 1996 at 11:38 A.M.

Sigrid I. Hedberg  
Schoolcraft Co. Reg. of Deeds

Register of Deeds Stamp & File Number

4. Lot No. \_\_\_\_\_, Recorded Plat \_\_\_\_\_  
5. Private Claims \_\_\_\_\_

Thomas P. O'Brien in a field survey on March 22 19 96 do hereby state that under requirements of P.A. 74, Michigan P.A. of 1970, the corner points mentioned in lines 1 and 2 above were in conformance with regulations and rules therefore as required in the current manual of survey instructions of the United States Department of the Interior, Bureau of Land Management or by a decree of a Court of Law and /or that the corner points mentioned in lines 3, 4 and 5 above were in conformance with the rules of the Michigan Board of Land Surveyors or by a Decree of a Court of Law; established, re-established, monumented, recovered, found as expressed below:

NOTE: Not more than 2 corners, all in the same town and range, may be recorded on this certificate.

1	A	B	C	D	E	F	G	H	I	J	K	L	M
2		6		5		4		3		2		1	
3													
4		7		8		9		10		11		12	
5													
6		18		17		16		15		14		13	
7													
8		19		20		21		22		23		24	
9													
10		30		29		28		27		26		25	
11													
12		31		32		33		34		35		36	
13													

A. Description of original monument and accessories and/or subsequent restoration:

K-1 (N.W. Corner Sec.1)  
May 30, 1841 William A. Burt D.S. set corner post.  
Y. Pine 20 N48E 40 W. Pine 30 N56W 38  
  
Sept. 12, 1850 Algernon Merryweather D.S. Corner 1&2 North Boundry.  
N. Pine 12" S56W 55 lks. N. Pine 14" S20E 53"


B. Description of corner evidence found and/or method applied in restoring or reestablishing corner:

K-1 May 11, 1961- Billy D. Buckler RLS, set a 1" pipe with 4" brass cap from one W. Pine stump bearing N56°W- 38 lks."Position checks well with good corner 1/2 mile West.  
  
March 22, 1996- Thomas P. O'Brien P.S. recovered a 1" pipe with 4" brass cap as set by Billy D. Buckler on May 11, 1961.

C. Description of monument for corner and accessories established to perpetuate locating the position of the corner:

K-1 Found Mich Dept. of Cons. 1" pipe with 4" brass cap stamped to identify.

Witnesses: Fd. 12" Red Pine- N50°W - 47.15' Ex. Cond.  
Fd. 12" Red Pine- N17°E - 38.20' " "  
Fd. 14" Red Pine- S62°E - 62.00' " "  
8" Red Pine- S46°W - 45.57' NBT  
4" Cedar Post - West - 1.5'

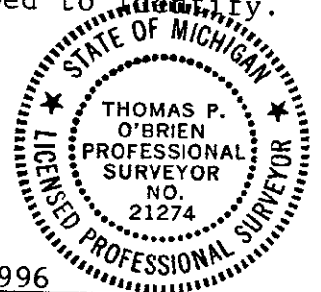

Signed by Thomas P. O'Brien

Date March 22, 1996

Surveyor's Michigan License No. 21274