

**SCHOOLCRAFT COUNTY JOB**  
**PEER GROUP APPROVED**  
**DATE 9/13/96**

**SURVEY & REMONUMENTATION**

NOV 21 1996

COMMISSION

LAND CORNER RECORDATION CERTIFICATE  
 Filing Requirement of Act 74, Mich. P.A. 1970

For corners in

<u>Schoolcraft</u> (County)	Located In:	Corner Code #
1. Public Land Survey	T42NR15W T43NR15W T__R__ T__R__	L-1 L-13 ✓
2. Property Controlling in Section	S__T__R__ S__T__R__	_____
3. Miscellaneous Property in Sec.	S__T__R__ S__T__R__	_____
4. Lot No. _____, Recorded Plat _____		
5. Private Claims _____		

Received & Filed this 30 day of Oct 1996 at 11:30 AM  
 Sigrid I. Hedberg  
 Schoolcraft Co. Reg. of Deeds

Register of Deeds Stamp & File Number

A	B	C	D	E	F	G	H	I	J	K	L	M
1												
2	6	5	4	3	2	1						
3												
4	7	8	9	10	11	12						
5												
6	18	17	16	15	14	13						
7												
8	19	20	21	22	23	24						
9												
10	30	29	28	27	26	25						
11												
12	31	32	33	34	35	36						
13												

Thomas P. O'Brien in a field survey on Oct. 15, 1996 do hereby state that under requirements of P.A. 74, Michigan P.A. of 1970, the corner points mentioned in lines 1 and 2 above were in conformance with regulations and rules therefore as required in the current manual of survey instructions of the United States Department of the Interior, Bureau of Land Management or by a decree of a Court of Law and for that the corner points mentioned in lines 3, 4 and 5 above were in conformance with the rules of the Michigan Board of Land Surveyors or by a Decree of a Court of Law; established, re-established, monumented, recovered, found as expressed below:

NOTE: Not more than 2 corners, all in the same town and range, may be recorded on this certificate.

A. Description of original monument and accessories and/or subsequent restoration:

L-1 (North 1/4 Corner Sec. 1)  
 Oct. 25, 1841 William A Burt D.S. set gr. section post.  
 Tamarack 6 N26E 58 links do. 2 N24W 40 "


B. Description of corner evidence found and/or method applied in restoring or reestablishing corner:

L-1 Oct. 15, 1996- Thomas P. O'Brien P.S. set a Schoolcraft Co. Monument midway and on line between the section corner to the West and the township corner to the East.

C. Description of monument for corner and accessories established to perpetuate locating the position of the corner:

L-1 Set Schoolcraft County Monument stamped to identify.

Witnesses: 4" Cedar- N 7°W -- 15.72' NBT  
 8" Cedar- N48°E - 36.80' NBT  
 8" Cedar- S81°E - 37.10' NBT  
 6" Cedar- S58°W - 25.20' NBT  
 4" Cedar Post - North - 1.5'

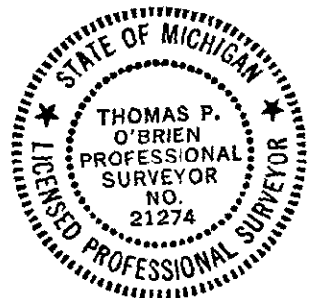

Signed by Thomas P. O'Brien  
 Surveyor's Michigan License No. 21274

Date October 15, 1996