LAND CORNER RECORDATION CERTIFICATE
Filing Requirement of Act 74, Mich. P.A. 1970 as Amended

For corners in

Schoolcraft
(County)

		Located In:		Corner Code #
1. Public Land Survey		T 43N	R 16W	I7
		T 43N	R 16W	J8
		T	R	
	S	T	R	
2. Property Controlling	S	T	R	
in Section	S	T	R	
3. Miscellaneous	S	T	R	
Property in Sec.	S	T	R	

Register of Deeds Stamp & File Number

4. Lot No. _____ , Recorded Plat_____

5. Private Claims

J8 Mar 28 2006
I7 May 24 2006

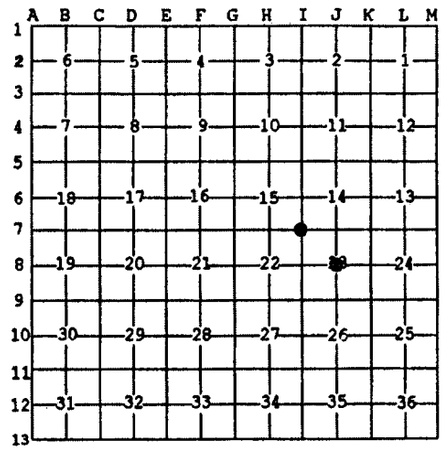

I, Stephan J. Szyszkoski, in a field survey on _____, 20 ____ do hereby state that under requirements of P.A. 74, Michigan P.A. of 1970, the corner points mentioned in lines 1 and 2 above were in conformance with regulations and rules therefore as required in the current manual of survey instructions of the United States Department of the Interior, Bureau of Land Management or by a decree of a Court of Law and /or that the corner points mentioned in lines 3, 4 and 5 above were in conformance with the rules of the Michigan Board of Land Surveyors or by a Decree of a Court of Law; established, re-established, monumented, recovered, found as expressed below:

NOTE: Not more than 2 corners, all in the same town and range, may be recorded on this certificate.

A. Description of original monument and accessories and/or subsequent restoration:

(I7) Corner common to Sections 14-15-22-23. 1977 - Recorded by Thomas P. O'Brien RLS, Liber 1 of LCR Page 162. Found BLM monument in 1976. 6" Maple N42W 10.2', 18" Beech S80E 36.9', 10" Beech S35E 25.0'.
(J8) Center of Section 23. Not established in the original survey. 1956 - G.A.Shadko, RLS, established the corner at the intersection of quarter lines. Set 4" dia. x42" concrete-filled iron pipe with a brass Michigan Dept. of Conservation cap. Beech 8 N41W 28.1', Beech 4 S51 30'W 17.2'. 1977 - Recorded by Thomas P. O'Brien RLS: Iron pipe with DNR cap. 24" Hemlock S32W 18.5', 8" Beech N20W 24.4'. (Liber 1 LCR Page 195).

B. Description of corner evidence found and/or method applied in restoring or reestablishing corner:

(I7) Recovered 4" dia. concrete monument with BLM brass cap in good condition and at record bearing and distance from the 1976 Beech witness trees. The Beech S35E has a broken top. Left the monument in place and made new witnesses as described below.
(J8) Recovered the 1956 monument in good condition and at record bearing and distance from the 1977 witnesses. My measurements show that the monument is located less than 1 foot from the intersection of straight lines connecting opposite 1/4 corners and I accept same as a careful and faithful establishment of the position of the corner.

C. Description of monument for corner and accessories established to perpetuate locating the position of the corner:

(I7) Found Bureau of Land Management concrete monument with brass cap. Set measuring nails in:

8" Maple N08E 16.9'	mrkd "S14 NBT"	
9" Maple N26W 10.35'	"S15 NBT"	
18" Beech S81E 36.95'	"S23 NBT"	
15" Maple S74W 8.22'	"S22 NBT"	

Bearings are magnetic. Distances are to nail with tag.

(J8) Fd. 4" iron pipe with brass Dept. of Conservation cap. Set measuring nails in:

22" Hemlock S42W 18.73'	mrkd "CS BT"	*
13" Beech N22W 24.3'	do	*
14" Y.Birch N37E 21.25'	do	
14" Beech S88W 14.75'	do	

Bearings are magnetic. Distances are to nail with tag. * denotes 1977 BT.

STATE OF MICHIGAN
STEPHAN J. SZYSZKOSKI
LAND SURVEYOR
No. 33986
LICENSED LAND SURVEYOR

Signed by Stephan J. Szyszkoski Date 12/6/06

Surveyor's Michigan License No. 33986

For the Michigan Department of Natural Resources, Office of Land and Facilities

FORM APPROVED BY MICHIGAN STATE BOARD OF PROFESSIONAL SURVEYORS, JAN. 28, 1971
Revised May 14, 1975
Revised Jan., 1983
Revised Oct., 1995