

LAND CORNER RECORDATION CERTIFICATE
Filing Requirement of Act 74, Mich. P.A. 1970 as Amended

For corners in

<u>Schoolcraft</u> (County)	Located In:	Corner Code #
1. Public Land Survey	T <u>43N</u> R <u>16W</u>	<u>I8</u>
	T _____ R _____	_____
	T _____ R _____	_____
2. Property Controlling in Section	S _____ T _____ R _____	_____
	S <u>23</u> T <u>43N</u> R <u>16W</u>	<u>4</u>
	S _____ T _____ R _____	_____
3. Miscellaneous Property in Sec.	S _____ T _____ R _____	_____
	S _____ T _____ R _____	_____
4. Lot No. _____, Recorded Plat _____		
5. Private Claims		

Register of Deeds Stamp & File Number

A	B	C	D	E	F	G	H	I	J	K	L	M
1												
2	6	5	4	3	2	1						
3												
4	7	8	9	10	11	12						
5												
6	18	17	16	15	14	13						
7												
8	19	20	21	22	23	24						
9												
10	30	29	28	27	26	25						
11												
12	31	32	33	34	35	36						
13												

Jan 10 2006

I, Stephan J. Szyszkoski, in a field survey on _____, 20____ do hereby state that under requirements of P.A. 74, Michigan P.A. of 1970, the corner points mentioned in lines 1 and 2 above were in conformance with regulations and rules therefore as required in the current manual of survey instructions of the United States Department of the Interior, Bureau of Land Management or by a decree of a Court of Law and /or that the corner points mentioned in lines 3, 4 and 5 above were in conformance with the rules of the Michigan Board of Land Surveyors or by a Decree of a Court of Law; established, re-established, monumented, recovered, found as expressed below:

NOTE: Not more than 2 corners, all in the same town and range, may be recorded on this certificate.

A. Description of original monument and accessories and/or subsequent restoration:


(I8) Quarter corner common to Sections 22 and 23. 1850 - Established by A.Merryweather, Deputy Surveyor, midway and on line between Section corners 40.00 chains north and south. Bearing trees: Hemlock 7 N85E 4 links, Hemlock 12 S88W 22 links. 1956 - Reestablished by G.A.Shadko RLS: "Found no evidence of corner or witness trees. Cor. was not set. It should be on line and half-way bet. N.W. & S.W. cor. Sec. 23". On his drawing describing his 1956 survey of the subdivision of Section 23, Mr. Shadko shows distances north and south 2651.8' to those Section corners.
 (4-Sec. 23) Northwest 1/16 corner, Section 23. Not established in the original survey.

B. Description of corner evidence found and/or method applied in restoring or reestablishing corner:

(I8) The original post and accessories were not recovered. Monumented the 1956 position described by Mr. Shadko: On the Section line between Section corners I7 and I9 2651.47' north and south. From the position thus established, I found a pipe, not of record, N01W 26.23' distant, which I did not accept as marking the position for the corner.
 (4-Sec. 23) Established the corner at the intersection of straight lines connecting opposite 1/16 corners. The position for the corner falls in the south shoulder of a road.

C. Description of monument for corner and accessories established to perpetuate locating the position of the corner:

(I8) Set 1"IDx36" I.pipe with 4" alum. MDNR cap. Set measuring nails in: 6" Balsam S15E 4.15' mrkd "1/4S NBT" 6" Maple N52E 18.93' do 10" Maple S45W 3.55' do 9" Hemlock N20W 33.3' do Bearings are magnetic. Distances are to nail with tag.	(4) Set 1"IDx36" I.pipe w/plastic cap stamped "MI DNR PS33986" flush with the ground surface. Set measuring nails in: 14" Hemlock S74W 17.35' 15" Maple N02E 38.8' 11" Hemlock S54E 30.4' 7" W.Birch S20W 49.45' Fd. iron under blacktop N1E 5.5' Bearings are magnetic. Distances to trees are to nail with tag.
--	---

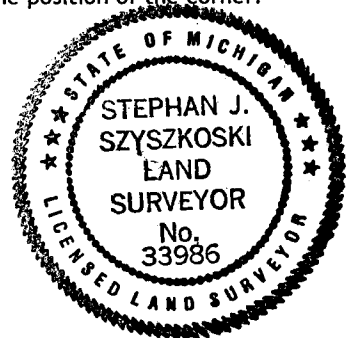

Signed by Stephan J. Szyszkoski
 Surveyor's Michigan License No. 33986

Date 12/6/06

For the Michigan Department of Natural Resources, Office of Land and Facilities