

LAND CORNER RECORDATION CERTIFICATE
Filing Requirement of Act 74, Mich. P.A. 1970 as Amended

For corners in

<u>Schoolcraft</u> (County)	Located In:	Corner Code #
1. Public Land Survey	T <u>43N</u> R <u>16W</u>	<u>I11</u>
	T _____ R _____	_____
	T _____ R _____	_____
2. Property Controlling in Section	S _____ T _____ R _____	_____
	S <u>26</u> T <u>43N</u> R <u>16W</u>	<u>2</u>
	S _____ T _____ R _____	_____
3. Miscellaneous Property in Sec.	S _____ T _____ R _____	_____
	S _____ T _____ R _____	_____

Register of Deeds Stamp & File Number

4. Lot No. _____, Recorded Plat _____
 5. Private Claims

I11 Jan 11 2006
 2 Mar 27 2006

I, Stephan J. Szyszkoski, in a field survey on _____, 20____ do hereby state that under requirements of P.A. 74, Michigan P.A. of 1970, the corner points mentioned in lines 1 and 2 above were in conformance with regulations and rules therefore as required in the current manual of survey instructions of the United States Department of the Interior, Bureau of Land Management or by a decree of a Court of Law and /or that the corner points mentioned in lines 3, 4 and 5 above were in conformance with the rules of the Michigan Board of Land Surveyors or by a Decree of a Court of Law; established, re-established, monumented, recovered, found as expressed below:

NOTE: Not more than 2 corners, all in the same town and range, may be recorded on this certificate.

A. Description of original monument and accessories and/or subsequent restoration:


(I11) Corner common to Sections 26-27-34-35. 1850 - Established by A.Merryweather, Deputy Surveyor. Set post. Cedar 10 S44E 11 links, Cedar 6 N78W 18 links. Found no subsequent record.
 (2-Sec. 26) East 1/16 corner between Sections 23 and 26. Not established in the original survey. Recorded by Thomas P. O'Brien RLS in 1982 as "Found 3/4" pipe" on a P.A. 132 survey for M.G.P. Development Corporation. Distance east to Section corner is shown as 1324.85' and distance south to a set iron bar as 33'.

B. Description of corner evidence found and/or method applied in restoring or reestablishing corner:

(I11) The original post and accessories were not recovered. Found no acceptable evidence of the position of the original corner on the ground. Reestablished the corner by double proportionate measurement to the original 1850 record between monumented corners 2658.58' north, 5290.42' east, 5317.17' south, and 5290.36' west.
 (2-Sec. 26) Found and accepted a 3/4" iron pipe, buried in the C/L of an E-W road. The pipe is substantially midway and on line between adjacent Quarter corner 1325.30' west and Section corner 1324.21' east, 0.12' north of a straight line between them. Found Mr. O'Brien's iron 33.0' south. Accepted the monument as a careful and faithful establishment of the position of the corner.

C. Description of monument for corner and accessories established to perpetuate locating the position of the corner:

(I11) Set 1"IDx36" I.pipe with 4" alum. MDNR cap. Set measuring nails in: 11" Cedar S71E 15.4' mrkd "S35 NBT" 6" W.Birch S33E 11.85' "S35 NBT" 5" W.Birch S84W 18.8' "S34 NBT" 8" Cedar North 15.1' "S26 NBT" Bearings are magnetic. Distances are to nail with tag.	(2) Fd. 3/4" iron pipe. Set measuring nails with tags in: 6" Maple S65W 49.3' mrkd "E1/16" BT"8" Maple in clump N40W 52.7' do 6" W.Pine S78W 53.8' do Found 1/2" iron bar South 33.0' Bearings are magnetic.
---	---

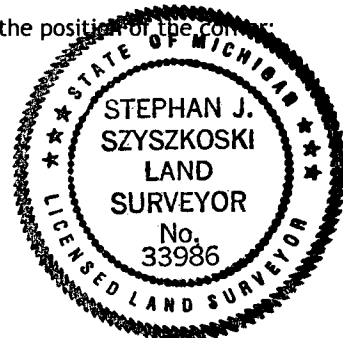

Signed by Stephan J. Szyszkoski
 Surveyor's Michigan License No. 33986

Date 12/6/06

For the Michigan Department of Natural Resources, Office of Land and Facilities