

**LAND CORNER RECORDATION CERTIFICATE**  
**Filing Requirement of Act 74, Mich. P.A. 1970 as Amended**

For corners in

<u>Schoolcraft</u> (County)	Located In:	Corner Code #
1. Public Land Survey	T <u>    </u> R <u>    </u>	<u>                    </u>
	T <u>    </u> R <u>    </u>	<u>                    </u>
	T <u>    </u> R <u>    </u>	<u>                    </u>
	S <u>12</u> T <u>43N</u> R <u>16W</u>	<u>7</u>
2. Property Controlling in Section	S <u>12</u> T <u>43N</u> R <u>16W</u>	<u>14</u>
	S <u>    </u> T <u>    </u> R <u>    </u>	<u>                    </u>
3. Miscellaneous Property in Sec.	S <u>    </u> T <u>    </u> R <u>    </u>	<u>                    </u>
	S <u>    </u> T <u>    </u> R <u>    </u>	<u>                    </u>
4. Lot No. <u>          </u> , Recorded Plat <u>                    </u>		
5. Private Claims		

Register of Deeds Stamp & File  
Number

	A	B	C	D	E	F	G	H	I	J	K	L	M
1													
2	6		5		4		3		2		1		
3													
4	7		8		9		10		11		12		
5													
6	18		17		16		15		14		13		
7													
8	19		20		21		22		23		24		
9													
10	30		29		28		27		26		25		
11													
12	31		32		33		34		35		36		
13													

14 Oct 25 2007  
7 May 07 2007


I, Stephan J. Szyszkoski, in a field survey on           , 20      do hereby state that under requirements of P.A. 74, Michigan P.A. of 1970, the corner points mentioned in lines 1 and 2 above were in conformance with regulations and rules therefore as required in the current manual of survey instructions of the United States Department of the Interior, Bureau of Land Management or by a decree of a Court of Law and /or that the corner points mentioned in lines 3, 4 and 5 above were in conformance with the rules of the Michigan Board of Land Surveyors or by a Decree of a Court of Law; established, re-established, monumented, recovered, found as expressed below:

**NOTE: Not more than 2 corners, all in the same town and range, may be recorded on this certificate.**

A. Description of original monument and accessories and/or subsequent restoration:  
 (7-Sec. 12) North 1/16 corner between Sec. 12 T43N-R16W and Section 7 T43N-R15W. 1969 - F.J.Bray RLS established the corner midway and on line between section corner to north and 1/4 corner to south. Set 1" iron pipe with 4" aluminum cap. 8" Cedar N55W 08 links, 17" W.Pine N70E 10.5 links.  
 (14-Sec. 12) South 1/16 corner between Section 12 T43N-R16W and Section 7 T43N-R15W. 1969 - Established by F.J.Bray RLS midway and on line between Section corner to south and Quarter corner to north. Set 1" iron pipe with 4" aluminum cap. 6" B.Spruce S85E 41.5 links, 12" W.Pine S37W 59 links.

B. Description of corner evidence found and/or method applied in restoring or reestablishing corner:  
 (7-Sec. 12) Found the 1969 monument in good condition, at record bearing and distance from the 1969 witnesses, both in good condition, and substantially at the record position midway between the government corners. Accepted same as a careful and faithful establishment of the position of the corner.  
 (14-Sec. 12) Found the 1969 monument in good condition, at record bearing and distance from the 1969 witnesses, both in good condition, and substantially at the record position midway between the government corners. Accepted same as a careful and faithful establishment of the position of the corner.

C. Description of monument for corner and accessories established to perpetuate locating the position of the corner:  
 (7) Found 1" ID I.pipe with 4" aluminum State of Michigan cap. Set measuring nail with MDNR tag in: 21" W.Pine N72E 7.85' open blaze (1969 BT)  
 9" Cedar N49W 5.65' do do  
 5" Cedar S46W 9.4' mrkd "N1/16 BT"  
 8" Cedar S52E 9.35' do  
 Bearings are magnetic.  
 (14) Found 1" ID I.pipe with 4" alum. State of Michigan cap. Set measuring nail with MDNR tag in: 17" W.Pine S40W 39.26' old blazes (1969 BT)  
 8" B.Spruce S80E 27.87' do do  
 5" B.Spruce N05W 15.64' mrkd "S1/16 BT"  
 16" W.Pine S50E 45.41' do  
 Bearings are magnetic.

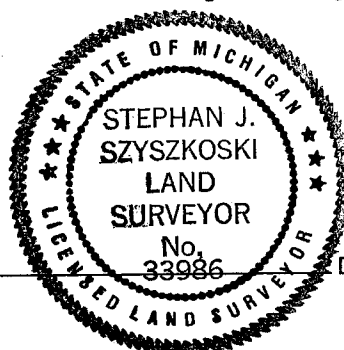

Signed by Stephan J. Szyszkoski Date 11/14/07

Surveyor's Michigan License No. 33986