

LAND CORNER RECORDATION CERTIFICATE
Filing Requirement of Act 74, Mich. P.A. 1970

For corners in
SCHODOLCRAFT
 County

	Located in:	Corner Code #
1. Public Land Survey	T <u>44N</u> R <u>16W</u>	<u>610</u>
	T <u>44N</u> R <u>16W</u>	<u>611</u>
	T _____ R _____	_____
	T _____ R _____	_____
2. Property Controlling in Section	S <u>27</u> T <u>44N</u> R <u>16W</u>	<u>3</u>
	S _____ T _____ R _____	_____
3. Miscellaneous Property in Sec.	S _____ T _____ R _____	_____
	S _____ T _____ R _____	_____

4. Lot No. _____, Recorded Plat _____
 5. Private Claims _____

I, Stephan J. Szyszkoski, in a field survey on June 30, 1992, 19_____, do hereby certify that under requirements of P.A. 74, Michigan P.A. of 1970, the corner points mentioned in lines 1 and 2 above were in conformance with regulations and rules therefore as required in the current manual of survey instructions of the United States Department of the Interior, Bureau of Land Management or by a decree of a Court of Law and/or that the corner points mentioned in lines 3, 4 and 5 above were in conformance with the rules of the Michigan Board of Land Surveyors or by a Decree of a Court of Law; established, re-established, monumented, re-monumented, recovered, found as expressed below:

NOTE: Not more than 4 corners, all in the same town and range, may be recorded on this certificate.

A. Description of original monument and accessories and/or subsequent restoration:

(610) Quarter corner common to Sections 27 and 28, T44N-R16W. Corner established by Deputy Surveyor William Ives in 1850. Original bearing trees: Maple 12 S60E 25, Maple 6 N95W 29. Original line notes show: 1) South 2.12 ch. Enter bottomland course NW & SE. 2) North 0.48 ch. Stream 70 links, course SE 100 links then NE. 3) North 21.88 ch. Leave bottomland course NW & ESE. 4) South 38.62 ch. Leave thick timber. Found no subsequent record of corner.
 (611) Section corner common to Sections 27-28-33-34, T44N-R16W. Corner established by U.S. Deputy Surveyor William Ives, 1850. Original bearing trees: Tamarack 6 S16W 14, Tamarack 10 N19E 47. Original line notes show: 1) North 1.50 ch., Leave thick timber, 2) North 40.12 ch. 1/4 corner, 3) East 1.08 ch. Open swamp, 4) East 15.38 ch. Stream 2 links course NE, 5) East 40.04 ch. 1/4 corner. (3) North 1/16 corner between Sections 27 and 28, T44N-R16W. Corner not established in original survey. Found no subsequent record.


B. Description of corner evidence found and/or method applied in restoring or reestablishing corner:

(610) Original post and accessories not recovered. Restored corner at an old squared wood post set by unknown persons. Corner as monumented is in accord with the record referenced above as follows: 1) checks. 2) Measured 0.38 ch. north to south edge of stream. Bank appears to have eroded as evidenced by old stumps in the stream bottom. Bend to NE checks. 3) checks. 4) checks. Position for corner also checks with original stream call for the north bank of stream made on the random. This call would not check if the corner were east or west of the monumented position. Distances North and South to recorded Section corners are reasonable.
 (611) Original post and accessories not recovered. Restored corner in accord with the original line calls as referenced above. 1) Checks. Timber has been logged but edge of open swamp is clear. 2) checks to an established corner. 3) checks. 4) checks. 5) checks to a probable original corner. Found no evidence of original line trees North, South, East or West. Found no original evidence of 1/4 corners South and West, or Section corners 1 mile South and West.
 (3) Established corner midway and on a straight line between Section corner 1331.03' North and Quarter corner 1331.03' South. Found no monumentation at this position. An old N-S blazed line is approximately 11' East of the corner.

C. Description of monument for corner and accessories established to perpetuate locating the position of the corner:

(610) Placed a 1"x32" painted iron pipe capped with a 4" dia. cast aluminum MDNR tablet. Blazed, scribed and set measuring nails in the following new bearing trees: 9" Cedar N28E 17.53' (1/4S NBT) 7" Maple S37E 32.21' (1/4S NBT) 7" Maple West 44.97' (1/4S NBT) 6" Maple N25W 21.95' (1/4S NBT) Placed a 7" squared spruce post and the old post North 1'. N-S cut line is West 18'.	(611) Placed a 1"x64" painted iron pipe capped with a 4" dia. cast aluminum MDNR tablet. Blazed, scribed, and placed measuring nails in the following new bearing trees: 3" Spruce S81W 33.00' (S33 NBT) 4" Balsam N48N 49.05' (S28 NBT) 14" Tamarack S50W 71.6' (S33 NBT) Placed a Squared post NE, 0.5'	(3) Placed a 1"x32" painted iron pipe capped with a 4" dia. cast aluminum MDNR tablet. Blazed, scribed, and placed measuring nails in the following bearing trees: 7" Maple N56W 13.15' (1/16) 8" Cedar N09E 23.47' (1/16 BT) 13" Cedar S88E 19.25' (1/16 BT) 6" Spruce South 10.10' (1/16 BT) Placed a 6" squared cedar post West, 1'.
--	---	--

Signed by Stephan J. Szyszkoski Date 7-20-92
 Surveyor's Michigan License No. 33986

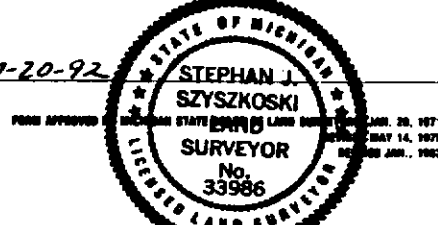

RECEIVED
 AUG 11 1992
 RECREATION DIVISION
 DEPT. OF NATURAL RESOURCES
 Register of Deeds Stamp & File Number

