LAND CORNER RECORDATION CERTIFICATE
Filing Requirement of Act 74, Mich. P.A. 1970 as Amended

For corners in

Schoolcraft (County)

	Located In:			Corner Code #
1. Public Land Survey		T 44N	R 16W	C5
		T	R	
		T	R	
	S	T	R	
2. Property Controlling	S 18	T 44N	R 16W	9
in Section	S	T	R	
3. Miscellaneous	S	T	R	
Property in Sec.	S	T	R	

Register of Deeds Stamp & File Number

4. Lot No. _____ , Recorded Plat_____

5. Private Claims

C5 Mar 07 2006
9 Dec 06 2006

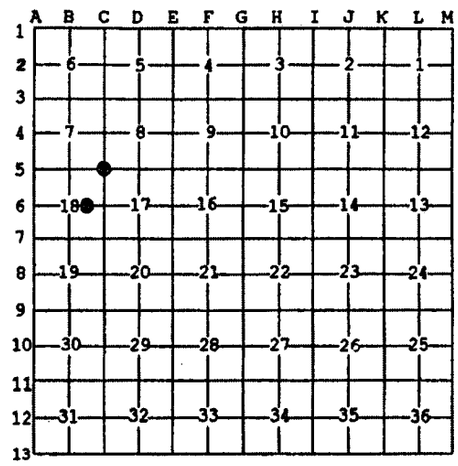

I, Stephan J. Szyszkoski, in a field survey on _____, 20 ____ do hereby state that under requirements of P.A. 74, Michigan P.A. of 1970, the corner points mentioned in lines 1 and 2 above were in conformance with regulations and rules therefore as required in the current manual of survey instructions of the United States Department of the Interior, Bureau of Land Management or by a decree of a Court of Law and /or that the corner points mentioned in lines 3, 4 and 5 above were in conformance with the rules of the Michigan Board of Land Surveyors or by a Decree of a Court of Law; established, re-established, monumented, recovered, found as expressed below:

NOTE: Not more than 2 corners, all in the same town and range, may be recorded on this certificate.

A. Description of original monument and accessories and/or subsequent restoration:

(C5) Corner common to Sections 7-8-17-18. 1957 - Record of Billy D. Buckler RLS states that Mr. Buckler recovered and perpetuated position monumented by Carl Christensen, being in accord with two original bearing trees, still in place. Description of corner monument: 2.5" pipe with brass cap. New witnesses: 12" W.Birch N26E 40 links, 11" Elm S59E 41 links.
(9-Sec. 18) East 1/16 corner, Section 18. Not established in the original survey.

B. Description of corner evidence found and/or method applied in restoring or reestablishing corner:

(C5) Recovered the Christensen monument in good condition and at record bearing and distance from the original BTs and new BTs noted in the 1957 record, now all dead. Left the monument in place and made new witnesses.
(9-Sec. 18) Established the corner midway and on a straight line between Quarter corner 1318.01' east and the intersection of 1/4 lines of Section 18 1318.01' west.

C. Description of monument for corner and accessories established to perpetuate locating the position of the corner:

(C5) Found 2.5" iron pipe with brass cap. Set measuring nails in:
8" Balsam S31W 23.3' mrkd "S18 NBT"
11" Ash S54E 24.45' "S17 NBT"
17" Birch N78E 19.1' "S8 NBT"
8" Balsam North 20.85' "S7 NBT"
Bearings are magnetic. Distances are to nail with tag.

(9) Set 1"IDx36" I.pipe with 4" alum. MDNR cap. Set measuring nails in:
11" J.Pine S51W 4.85' mrkd "E1/16 BT"
11" J.Pine N67W 12.9' do
7" J.Pine East 25.6' do
10" J.Pine S63E 38.42' do
Bearings are magnetic. Distances are to nail with tag.

STATE OF MICHIGAN
STEPHAN J. SZYSZKOSKI
LAND SURVEYOR
No. 33986
LICENSED LAND SURVEYOR

Signed by Stephan J. Szyszkoski Date 1/17/07

Surveyor's Michigan License No. 33986

For the Michigan Department of Natural Resources, Office of Land and Facilities

FORM APPROVED BY MICHIGAN STATE BOARD OF PROFESSIONAL SURVEYORS, JAN. 28, 1971
Revised May 14, 1975
Revised Jan., 1983
Rervised Oct., 1995