

LAND CORNER RECORDATION CERTIFICATE
Filing Requirement of Act 74, Mich. P.A. 1970 as Amended

For corners in

<u>Schoolcraft</u> (County)	Located In:	Corner Code #
1. Public Land Survey	T <u>44N</u> R <u>16W</u>	<u>C6</u>
	T _____ R _____	_____
	T _____ R _____	_____
2. Property Controlling in Section	S _____ T <u>44N</u> R <u>16W</u>	<u>7</u>
	S _____ T _____ R _____	_____
3. Miscellaneous Property in Sec.	S _____ T _____ R _____	_____
	S _____ T _____ R _____	_____
4. Lot No. _____, Recorded Plat _____		
5. Private Claims	C6 Dec 04 2006	
	7 Dec 19 2006	

**Register of Deeds Stamp & File
Number**

I, Stephan J. Szyszkoski, in a field survey on _____, 20____ do hereby state that under requirements of P.A. 74, Michigan P.A. of 1970, the corner points mentioned in lines 1 and 2 above were in conformance with regulations and rules therefore as required in the current manual of survey instructions of the United States Department of the Interior, Bureau of Land Management or by a decree of a Court of Law and /or that the corner points mentioned in lines 3, 4 and 5 above were in conformance with the rules of the Michigan Board of Land Surveyors or by a Decree of a Court of Law; established, re-established, monumented, recovered, found as expressed below:

1	A	B	C	D	E	F	G	H	I	J	K	L	M
2		6		5		4		3		2		1	
3													
4		7		8		9		10		11		12	
5													
6		18		17		16		15		14		13	
7													
8		19		20		21		22		23		24	
9													
10		30		29		28		27		26		25	
11													
12		31		32		33		34		35		36	
13													

NOTE: Not more than 2 corners, all in the same town and range, may be recorded on this certificate.

A. Description of original monument and accessories and/or subsequent restoration:


(C6) Quarter corner common to Sections 17 and 18. 1850 - Established by William Ives, Deputy Surveyor: N30'W corrected between Sections 17 & 18 ...39.76 Set quarter section post. Yellow Pine 18 S76W 45 links, Spruce Pine 10 N07E 35 links. ...79.52 Post set corner of Sections 7,8,17,18.
 (7-Sec. 18) North 1/16 corner between Sections 17 and 18. Not established in the original survey.

B. Description of corner evidence found and/or method applied in restoring or reestablishing corner:

(C6) The original post and accessories were not recovered. Reestablished the corner by single proportionate measurement to the original record, on the Section line between Section corners 2629.46' north and south. From the position thus established, I found a 1 1/2" iron pipe, not of record, N73W 25.8' distant, and a 1/2" iron pipe South 44.7' distant. Both pipes were placed by persons unknown.
 (7-Sec. 18) Established the corner on the Section line and midway between Section corner 1314.73' north and Quarter corner 1314.73' south.

C. Description of monument for corner and accessories established to perpetuate locating the position of the corner:

(C6) Set 1"IDx36" I.pipe with 4" alum. MDNR cap. Set measuring nails in: 8" J.Pine S82E 4.07' mrkd "1/4S NBT" 10" J.Pine N57W 12.05' do 15" J.Pine N06E 43.35' do 6" J.Pine S40W 9.45' do Bearings are magnetic. Distances are to nail with tag.	(7) Set 1"IDx36" I.pipe with 4" alum. MDNR cap. Set measuring nails in: 22" W.Pine S73W 31.0' mrkd "N1/16 BT" 13" Maple N83W 31.3' do 6" Balsam S37W 15.6' do 5" Balsam S07E 1.92' do Bearings are magnetic. Distances are to nail with tag.
--	--

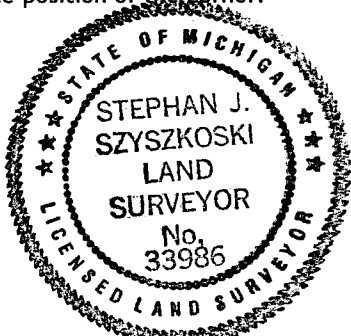

Signed by Stephan J. Szyszkoski
 Surveyor's Michigan License No. 33986

Date 1/17/07