LAND CORNER RECORDATION CERTIFICATE
Filing Requirement of Act 74, Mich. P.A. 1970 as Amended

For corners in

Schoolcraft (County)

		Located In:	Corner Code #
1. Public Land Survey		T 44N R 16W	C7
		T 44N R 16W	C8
		T ___ R ___	
	S___	T ___ R ___	
2. Property Controlling	S___	T ___ R ___	
in Section	S___	T ___ R ___	
3. Miscellaneous	S___	T ___ R ___	
Property in Sec.	S___	T ___ R ___	

Register of Deeds Stamp & File Number

4. Lot No. _____ , Recorded Plat_____

5. Private Claims

C8 Aug 07 2006
C7 Dec 19 2006

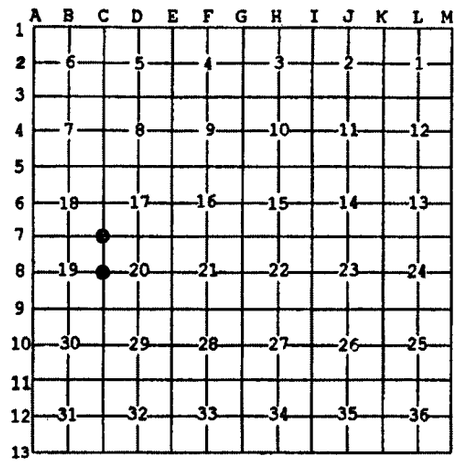

I, Stephan J. Szyszkoski, in a field survey on _____, 20 ____ do hereby state that under requirements of P.A. 74, Michigan P.A. of 1970, the corner points mentioned in lines 1 and 2 above were in conformance with regulations and rules therefore as required in the current manual of survey instructions of the United States Department of the Interior, Bureau of Land Management or by a decree of a Court of Law and /or that the corner points mentioned in lines 3, 4 and 5 above were in conformance with the rules of the Michigan Board of Land Surveyors or by a Decree of a Court of Law; established, re-established, monumented, recovered, found as expressed below:

NOTE: Not more than 2 corners, all in the same town and range, may be recorded on this certificate.

A. Description of original monument and accessories and/or subsequent restoration:

(C7) Corner common to Sections 17-18-19-20. 1850 - Established by William Ives, Deputy Surveyor: S14'E corrected between Sections 19 & 20. Post set ...Spruce Pine 8 S48E 30 links, Spruce Pine 10 N64W 47 links. The original plat gives distances in chains to adjacent Section corners: 79.52 north, 79.68 east, 79.80 south, and 77.86 west.
(C8) Quarter corner common to Sections 19 and 20. 1850 - Established by William Ives, Deputy Surveyor: S14'E Corrected between Sections 19 & 20 ...39.90 Set quarter section post. Tamarack 5 N58E 9 links, Spruce 7 S42W 50 links. ...79.80 Section corner.

B. Description of corner evidence found and/or method applied in restoring or reestablishing corner:

(C7) The original post and accessories were not recovered. Found no acceptable evidence of the position of the original corner on the ground. Reestablished the corner by double proportionate measurement to the original record between Section corners 5258.92' north, 5271.01' east, 5277.51' south, and 5150.58' west.
(C8) The original post and accessories were not recovered. Found no acceptable evidence of the position of the original corner on the ground. Reestablished the corner by proportionate measurement to the original record, on the Section line between Section corners 2638.75' north and south.

C. Description of monument for corner and accessories established to perpetuate locating the position of the corner:

(C7) Set 1"IDx36" I.pipe with 4" alum. MDNR cap. Set measuring nails in:
6" J.Pine S64E 4.47' mrkd "S20 NBT"
10" J.Pine S22W 19.45' "S19 NBT"
10" J.Pine N23W 13.55' "S18 NBT"
8" J.Pine N60E 11.65' "S17 NBT"
Bearings are magnetic. Distances are to nail with tag.

(C8) Set 1"x36" I.pipe with 4" alum. MDNR cap. Set measuring nails in:
2" Spruce S25W 46.15' no marks
3" Tamarack S37W 58.2' do
5" Tamarack N05W 74.1' mrkd "1/4S NBT"
4" J.Pine N35E 108.35' do
Bearings are magnetic. Distances are to nail with tag.

STATE OF MICHIGAN
STEPHAN J. SZYSZKOSKI
LAND SURVEYOR
No. 33986
LICENSED LAND SURVEYOR

Signed by Stephan J. Szyszkoski Date 1/17/07

Surveyor's Michigan License No. 33986

For the Michigan Department of Natural Resources, Office of Land and Facilities

FORM APPROVED BY MICHIGAN STATE BOARD OF PROFESSIONAL SURVEYORS, JAN. 28, 1971
Revised May 14, 1975
Revised Jan., 1983
Rervised Oct., 1995