

**LAND CORNER RECORDATION CERTIFICATE**  
**Filing Requirement of Act 74, Mich. P.A. 1970 as Amended**

For corners in

<u>Schoolcraft</u> (County)	Located In:	Corner Code #
1. Public Land Survey	T _____ R _____	_____
	T _____ R _____	_____
	T _____ R _____	_____
2. Property Controlling in Section	S _____ T _____ R _____	_____
	S 19 T 44N R 16W	14
	S 20 T 44N R 16W	1
3. Miscellaneous Property in Sec.	S _____ T _____ R _____	_____
	S _____ T _____ R _____	_____

Register of Deeds Stamp & File  
Number

4. Lot No. \_\_\_\_\_, Recorded Plat \_\_\_\_\_  
 5. Private Claims

1 Dec 04 2006  
 14 Aug 07 2006

I, Stephan J. Szyszkoski, in a field survey on \_\_\_\_\_, 20\_\_\_\_ do hereby state that under requirements of P.A. 74, Michigan P.A. of 1970, the corner points mentioned in lines 1 and 2 above were in conformance with regulations and rules therefore as required in the current manual of survey instructions of the United States Department of the Interior, Bureau of Land Management or by a decree of a Court of Law and /or that the corner points mentioned in lines 3, 4 and 5 above were in conformance with the rules of the Michigan Board of Land Surveyors or by a Decree of a Court of Law; established, re-established, monumented, recovered, found as expressed below:

**NOTE: Not more than 2 corners, all in the same town and range, may be recorded on this certificate.**

A. Description of original monument and accessories and/or subsequent restoration:


- (14-Sec. 19) South 1/16 corner between Sections 19 and 20. Not established in the original survey.
- (1-Sec. 20) West 1/16 corner between Sections 17 and 20. Not established in the original survey.

B. Description of corner evidence found and/or method applied in restoring or reestablishing corner:

- (14-Sec. 19) Established the corner midway and on the Section line between Quarter corner 1319.38' north and Section corner 1319.38' south.
- (1-Sec. 20) Established the corner midway and on the Section line between Section corner 1317.75' west and Quarter corner 1317.75' east.

C. Description of monument for corner and accessories established to perpetuate locating the position of the corner:

- |   |  |
|---|--|
| (14) Set 1"IDx36" I.pipe with 4" alum.<br>MDNR cap. Set measuring nails in: | (1) Set 1"IDx36" I.pipe with 4" alum.<br>MDNR cap. Set measuring nails in: |
| 6" J.Pine S75E 20.85' mrkd "S1/16 8T"                                       | 6" J.Pine N15E 4.49' mrkd "W1/16 8T"                                       |
| 9" R.Pine S18E 33.0' do   | 6" Tamarack N46W 12.08' do   |
| 16" W.Pine N59W 56.1' do  | 5" J.Pine S48W 22.17' do   |
| 5" J.Pine N40E 46.45' do  | 5" J.Pine S23E 22.43' do   |
| Bearings are magnetic. Distances are to nail with tag.                      | Bearings are magnetic. Distances are to nail with tag.                     |

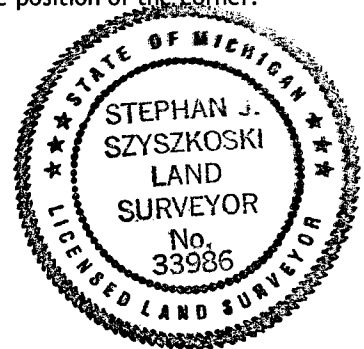

Signed by Stephan J. Szyszkoski  
 Surveyor's Michigan License No. 33986

Date 1/17/07

For the Michigan Department of Natural Resources, Office of Land and Facilities