LAND CORNER RECORDATION CERTIFICATE
Filing Requirement of Act 74, Mich. P.A. 1970 as Amended

For corners in

Schoolcraft
(County)

	Located In:	Corner Code #
1. Public Land Survey	T 45N R 16W	I9
	T 45N R 16W	I13
	T ___ R ___	
	S___ T ___ R ___	
2. Property Controlling	S___ T ___ R ___	
in Section	S___ T ___ R ___	
3. Miscellaneous	S___ T ___ R ___	
Property in Sec.	S___ T ___ R ___	

Register of Deeds Stamp & File Number

4. Lot No. _____ , Recorded Plat_____

5. Private Claims

I13 Jul 24 2006
I9 Jul 20 2006

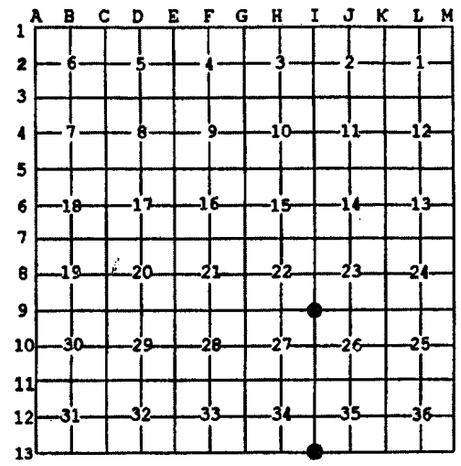

I, Stephan J. Szyszkoski, in a field survey on _____, 20 ____ do hereby state that under requirements of P.A. 74, Michigan P.A. of 1970, the corner points mentioned in lines 1 and 2 above were in conformance with regulations and rules therefore as required in the current manual of survey instructions of the United States Department of the Interior, Bureau of Land Management or by a decree of a Court of Law and /or that the corner points mentioned in lines 3, 4 and 5 above were in conformance with the rules of the Michigan Board of Land Surveyors or by a Decree of a Court of Law; established, re-established, monumented, recovered, found as expressed below:

NOTE: Not more than 2 corners, all in the same town and range, may be recorded on this certificate.

A. Description of original monument and accessories and/or subsequent restoration:

(I9) Corner common to Sections 22-23-26-27. 1965 - Remonumented in the original position by F.J.Bray RLS from one original BT W.Pine 18" S60W 50 links. Set 1" Iron Pipe with 4" aluminum cap. 7" Jack Pine N30W 52.5 links, 19" Red Pine S65E 121 links.
(I13) Corner common to Sections 34-35 T45N-R16W and Sections 2-3 T44N-R16W. 1965 - recorded by F.J.Bray RLS as having been reestablished from original BTs W.Pine N55W 32 links and W.Pine S44W 69 links. 2"x4.5' iron pipe with witnesses: 6" Red Maple S61E 19 links, 6" Red Maple S89W 29 links, 8" Y.Birch N06E 16 links, 11" Cedar N29W 116 links.

B. Description of corner evidence found and/or method applied in restoring or reestablishing corner:

(I9) Recovered the 1965 monument in good condition and at record bearing and distance from the 1965 witness trees, both in good condition with overgrown blazes. Accepted the monument a careful and faithful perpetuation of the position of the original corner. The original BT W.Pine noted in the 1965 record is down, at record bearing and distance.
(I13) Recovered the 2" pipe described in the 1965 record, in good condition, and at record bearing and distance from two of the four 1965 witness trees, in good condition. The 1965 R.Maple S61E and 11" Cedar N29W are now gone. The original BTs noted in the 1965 record were not apparent. Accepted the monument as a careful and faithful perpetuation of the position of the original corner.

C. Description of monument for corner and accessories established to perpetuate locating the position of the corner:

(I9) Found 1"ID I.pipe with 4" alum. MDNR cap. Set measuring nails in:
12" J.Pine N30W 35.55' mrkd "S22" *
23" R.Pine S60E 80.35' "S26" *
8" J.Pine N77E 12.95' mrkd "S23 NBT"
6" J.Pine S71W 8.55' "S27 NBT"
Bearings are magnetic. Distances are to nail with tag. * denotes 1965 NBT.

(I13) Found 2" Iron pipe. Set measuring nails in:
11" R.Maple N87W 18.65' mrkd "S34" *
12" Y.Birch N08E 10.65' "S35" *
9" Beech S08W 12.3' mrkd "S3 NBT"
10" Beech S60E 30.7' "S2 NBT"
Bearings are magnetic. Distances are to nail with tag. * denotes 1965 NBT.

STATE OF MICHIGAN
STEPHAN J. SZYSZKOSKI
LAND SURVEYOR
No. 33986
LICENSED LAND SURVEYOR

Signed by Stephan J. Szyszkoski Date 2/28/07

Surveyor's Michigan License No. 33986

For the Michigan Department of Natural Resources, Office of Land and Facilities

FORM APPROVED BY MICHIGAN STATE BOARD OF PROFESSIONAL SURVEYORS, JAN. 28, 1971
Revised May 14, 1975
Revised Jan., 1983
Revised Oct., 1995