

MICHIGAN  
DEPARTMENT OF CONSERVATION  
FORESTRY DIVISION

LAND CORNER RECORD

T46 & 47 NR 13 W ..

----- Schoolcraft ----- COUNTY

DESCRIPTION OF CORNER 1/4 Corner between Sections 5 and 32 -----

DESCRIPTION OF CORNER MONUMENT 1" pipe with 4" brass cap -----

WITNESSES TO CORNER 10" White Birch ----- S 64° W ----- 132 links -----

30" W. Pine Stump ----- N 53° E ----- 58 links -----


DESCRIPTION IN DETAIL AS TO HOW CORNER WAS LOCATED AND IDENTIFIED OR RESTORED.

Corner established by proportionate measure by Survey Crew.

No original evidence.

Corner placed 1 link East and 45 1/2 links South of 40.00 ch. from West.

Corner placed and witnessed June 24, 1955.

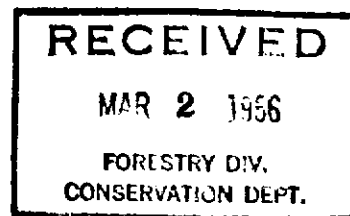

SURVEYORS SEAL

SIGNED Billy D. Buckler DATE 2/28/56  
REGISTERED LAND SURVEYOR