

MICHIGAN
DEPARTMENT OF CONSERVATION
FORESTRY DIVISION

LAND CORNER RECORD

T46 & 47NR 13 & 14 W

Schoolcraft COUNTY

DESCRIPTION OF CORNER Section Corner common to Sections 1, 6, 31, 36

DESCRIPTION OF CORNER MONUMENT 1" pipe with 4" brass cap

WITNESSES TO CORNER 18" Red Pine N 62° W 13 links

14" Red Pine S 21° W 86 links

DESCRIPTION IN DETAIL AS TO HOW CORNER WAS LOCATED AND IDENTIFIED OR RESTORED.


Section Corner established by Survey Crew.

One probable B.T. in place, badly burned.

Corner placed 32 links south and 14 links west of 80.00 ch. from North.

Corner placed and witnessed June 24, 1955.

SURVEYORS SEAL

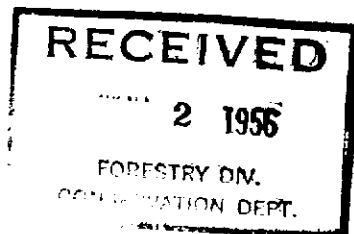

SIGNED Billy D. Buckles
REGISTERED LAND SURVEYOR

DATE 2/28/56