

MICHIGAN
DEPARTMENT OF CONSERVATION
FORESTRY DIVISION

LAND CORNER RECORD

T46 & 47 NR 13 W . . .

----- Schoolcraft ----- COUNTY

DESCRIPTION OF CORNER Section Corner common to Sections 31, 32, 5, 6 . . .

DESCRIPTION OF CORNER MONUMENT 1" pipe with 4" brass cap

WITNESSES TO CORNER 12" White Pine . . . S 24° W . . . 139 links

26" White Pine . . . N 80° W . . . 154 links

DESCRIPTION IN DETAIL AS TO HOW CORNER WAS LOCATED AND IDENTIFIED OR RESTORED.


Corner established by Survey Crew by Double Proportionate Measure.

No original evidence.

Corner placed 41 links South and 4 links West of 79.42 ch. from West.

Corner placed and witnessed June 24, 1955.

SURVEYORS SEAL

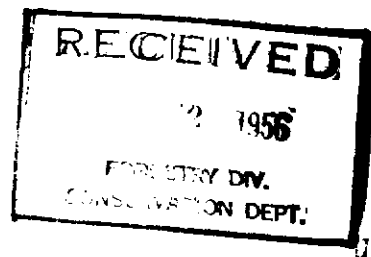

SIGNED

Billy D. Buckles
REGISTERED LAND SURVEYOR

DATE 2/28/56