

MICHIGAN  
DEPARTMENT OF CONSERVATION  
FORESTRY DIVISION

LAND CORNER RECORD

T46&47 NR 13 W ..

----- Schoolcraft ----- COUNTY

DESCRIPTION OF CORNER 1/4 Corner between Sections 3 and 34 .....

DESCRIPTION OF CORNER MONUMENT 1" pipe with 4" brass cap .....

WITNESSES TO CORNER 12" Red Pine N 30° W 108 links .....


14" White Pine S 4° E 110 links .....

DESCRIPTION IN DETAIL AS TO HOW CORNER WAS LOCATED AND IDENTIFIED OR  
RESTORED.

Corner found by Survey Crew.

2 original B.T.'s in place, good condition.

Corner placed and witnessed June 16, 1955.

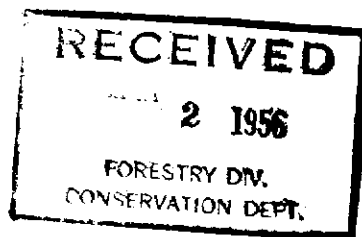

SURVEYORS SEAL

SIGNED Billy D. Buckles DATE 2/28/56  
REGISTERED LAND SURVEYOR