

MICHIGAN
DEPARTMENT OF CONSERVATION
FORESTRY DIVISION

LAND CORNER RECORD

T. 47.. NR 13 W. . .

----- Schoolcraft ----- COUNTY

DESCRIPTION OF CORNER 1/4 Corner between Sections 27 and 34 -----

DESCRIPTION OF CORNER MONUMENT 1" pipe with 4" brass cap -----


WITNESSES TO CORNER 20" W. Pine Stump S 70° E 99 links -----

20" W. Pine Stump S 7° W 66 links -----

DESCRIPTION IN DETAIL AS TO HOW CORNER WAS LOCATED AND IDENTIFIED OR RESTORED.

Corner found by Survey Crew. One original B.T. in place, good condition.

Corner placed and witnessed June 16, 1955.

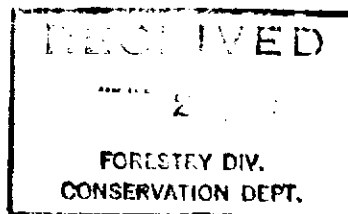

SURVEYORS SEAL

SIGNED Billy D. Buckler DATE 2/28/56
REGISTERED LAND SURVEYOR