

MICHIGAN
DEPARTMENT OF CONSERVATION
FORESTRY DIVISION

LAND CORNER RECORD

T46&47NR 13 W

Schoolcraft COUNTY

DESCRIPTION OF CORNER 1/4 Corner between Sections 4 and 33

DESCRIPTION OF CORNER MONUMENT 1" pipe with 4" brass cap

WITNESSES TO CORNER 28" W. Pine Stump N 40° E 47 links

36" W. Pine Stump S 58° E 49 links


DESCRIPTION IN DETAIL AS TO HOW CORNER WAS LOCATED AND IDENTIFIED OR RESTORED.

Corner established in line proportionate distance by Survey Crew.

Corner placed 15 links East and 6 links South of 45 ch. marker from West.

Corner placed and witnessed June 16, 1955.

SURVEYORS SEAL

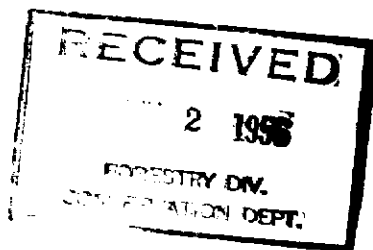

SIGNED

Billy D. Buckler
REGISTERED LAND SURVEYOR

DATE 2/28/56