

MICHIGAN
DEPARTMENT OF CONSERVATION
FORESTRY DIVISION

LAND CORNER RECORD

T46&47 NR 13 W ..

..... Schoolcraft COUNTY

DESCRIPTION OF CORNER Section Corner common to Sections 3, 4, 33, 34 ..

DESCRIPTION OF CORNER MONUMENT .. 1" pipe with 4" brass cap ..

WITNESSES TO CORNER .. 12" W. Pine Stump .. N 61° E .. 87 links ..

..... 14" W. Pine Stump .. S 59° W .. 41 links ..


DESCRIPTION IN DETAIL AS TO HOW CORNER WAS LOCATED AND IDENTIFIED OR RESTORED.

Corner found by Survey Crew.

2 original B.T.'s in place; one fair condition, one poor condition.

Corner placed and witnessed June 16, 1955.

SURVEYORS SEAL

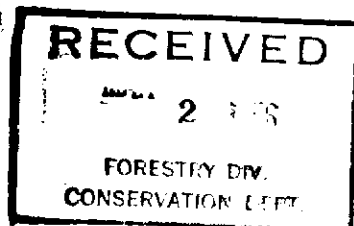

SIGNED

Billy D. Buckles
REGISTERED LAND SURVEYOR

DATE 2/28/56