

MICHIGAN
DEPARTMENT OF CONSERVATION
FORESTRY DIVISION

LAND CORNER RECORD

T. 45-46N N. R. 13W


Schoolcraft COUNTY

DESCRIPTION OF CORNER Sec. Cor. common to Secs. 3-4-33-34

CORNER MONUMENT 1" pipe with 4" aluminum cap. Bronze plaque in concrete monument.
"U.S. Dept. of Agriculture, Biological Survey."

DATE MONUMENT PLACED AND WITNESSED 9-16-70

WITNESSES TO CORNER..... 10" Cedar (S33 NBT) N10°W 40.3'

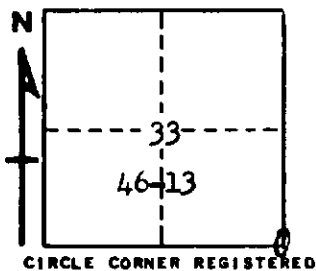

9" Cedar (S34 NBT) N58°E 24.8'

AND

DESCRIPTION IN DETAIL AS TO HOW CORNER WAS LOCATED AND IDENTIFIED OR RESTORED.

This corner replaced as set by U.S.D.A. in 1935.

Found no evidence of original witnesses.

Corner lies in north margin of a wet alder swamp.

SURVEYOR'S SEAL

SIGNED Billy D. Buckler
BILLY D. BUCKLER
REGISTERED LAND SURVEYOR

DATE 10-5-70