

MICHIGAN
DEPARTMENT OF CONSERVATION
FORESTRY DIVISION

LAND CORNER RECORD

T. 46N N.R. 14W


Schoolcraft COUNTY

DESCRIPTION OF CORNER Sec. Corner common to sections 14-15-22-23

CORNER MONUMENT 1" pipe with 4" aluminum cap.

DATE MONUMENT PLACED AND WITNESSED 8-3-62

WITNESSES TO CORNER..... NBT's: None

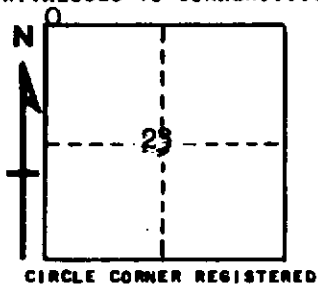

CIRCLE CORNER REGISTERED

AND

DESCRIPTION IN DETAIL AS TO HOW CORNER WAS LOCATED AND IDENTIFIED OR RESTORED.

This corner re-established midway and on line between two section corners. No evidence of original corner.

Corner lies on south bank of E-W ditch.

SURVEYOR'S SEAL

SIGNED Billy D. Buckler DATE July 19, 1963
REGISTERED LAND SURVEYOR
Billy D. Buckler