

LAND CORNER RECORDATION CERTIFICATE
Filing Requirement of Act 74, Mich. P.A. 1970 as Amended

For corners in

<u>Schoolcraft</u> (County)	Located In:	Corner Code #
1. Public Land Survey	T <u>46N</u> R <u>14W</u>	<u>L7</u>
	T <u>46N</u> R <u>14W</u>	<u>I5</u>
	T _____ R _____	_____
	S _____ T _____ R _____	_____
2. Property Controlling in Section	S _____ T _____ R _____	_____
	S _____ T _____ R _____	_____
3. Miscellaneous Property in Sec.	S _____ T _____ R _____	_____
	S _____ T _____ R _____	_____

4. Lot No. _____, Recorded Plat _____
 5. Private Claims I5 Oct 02 2003
 L7 Sep 30 2003

I, Stephan J. Szyszkoski, in a field survey on _____, 20____ do hereby state that under requirements of P.A. 74, Michigan P.A. of 1970, the corner points mentioned in lines 1 and 2 above were in conformance with regulations and rules therefore as required in the current manual of survey instructions of the United States Department of the Interior, Bureau of Land Management or by a decree of a Court of Law and /or that the corner points mentioned in lines 3, 4 and 5 above were in conformance with the rules of the Michigan Board of Land Surveyors or by a Decree of a Court of Law; established, re-established, monumented, recovered, found as expressed below:

NOTE: Not more than 2 corners, all in the same town and range, may be recorded on this certificate.

A. Description of original monument and accessories and/or subsequent restoration:


(L7) Quarter corner common to Sections 13-24. 1962: Billy D. Buckler RLS reestablished the corner midway and on line between Section corners. Set 1" I.pipe with 4" aluminum cap. 9" Jack Pine N60W 29 links, 6" Jack Pine S06E 22 links.
 (I5) Corner common to Sections 10-11-14-15. 1962: Billy D. Buckler RLS reestablished the corner by double proportionate measure between corners 0.5 miles North, 3 miles South, 2 miles East, and 1.5 miles West. Set 1" pipe with 4" aluminum cap. 9" J.Pine S71W 20 links, 8" J.Pine S20E 17.5 links, 9" J.Pine N16W 17.5 links.

B. Description of corner evidence found and/or method applied in restoring or reestablishing corner:

(L7) Found the 1962 monument in good condition. The 1962 witnesses were not recovered. The 1962 position for this corner is not accepted due to the reestablishment by the undersigned of corners K7 and M7, upon which the position of this corner depends. Reestablished the corner midway and on a line of mean true bearing between those two reestablished corners, which are 2645.62' West and East. The 1962 position, subsequently destroyed, is S84W 55.62' distant. Found no evidence of the original 1850 bearing trees.
 (I5) Recovered the 1962 monument in good condition and at record bearing and distance from the J.Pine witnesses, all now dead. The 1962 position for the corner is not accepted due to the reestablishment by the undersigned of corner M5 upon which the location of this corner depends. I reestablished the corner by double proportionate measure between Quarter corner 7955.15' West, Section corner 10571.59' East, Quarter corner 2675.43' North, and Section corner 15916.96' South. From the corner thus established, the 1962 position, now destroyed, is N79W 36.55' distant. Found no evidence of the original 1850 bearing trees.

C. Description of monument for corner and accessories established to perpetuate locating the position of the corner:

(L7) Set a 1"10x36" I.pipe with 4" alum. MDNR cap. Blazed, scribed, and set measuring nails in:	(I5) Set 1"10x36" I.pipe with 4" aluminum MDNR cap. Blazed, scribed, and set measuring nails in:
5" J.Pine N57E 19.6' "1/4S NBT"	3" J.Pine S75W 5.35' "S15 NBT"
6" J.Pine N36W 24.6' do	3" J.Pine N20E 2.8' "S11 NBT"
10" J.Pine S60W 57.9' do	3" J.Pine N83E 18.35' "S11 NBT"
7" J.Pine S07E 34.7' do	3" J.Pine S28E 26.4' "S14 NBT"
Placed a cedar post adjacent. Bearings are magnetic. Distances are to nail with tag.	Set cedar post adjacent. Bearings are magnetic. Distances are to nail with tag.

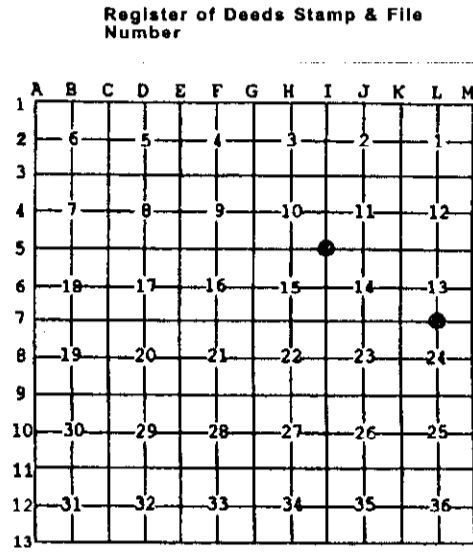

Signed by Stephan J. Szyszkoski
 Surveyor's Michigan License No. 33986

Date 11/18/03

