

LAND CORNER RECORDATION CERTIFICATE
Filing Requirement of Act 74, Mich. P.A. 1970 as Amended

For corners in

<u>Schoolcraft</u> (County)	Located In:	Corner Code #
1. Public Land Survey	T <u>46N</u> R <u>14W</u>	<u>K5</u>
	T <u>46N</u> R <u>14W</u>	<u>L5</u>
	T _____ R _____	_____
	S _____ T _____ R _____	_____
2. Property Controlling in Section	S _____ T _____ R _____	_____
	S _____ T _____ R _____	_____
3. Miscellaneous Property in Sec.	S _____ T _____ R _____	_____

Register of Deeds Stamp & File Number

4. Lot No. _____, Recorded Plat _____
 5. Private Claims _____

L5 Sep 16 2003
 K5 Oct 02 2003

I, Stephan J. Szyszkoski, in a field survey on _____, 20____ do hereby state that under requirements of P.A. 74, Michigan P.A. of 1970, the corner points mentioned in lines 1 and 2 above were in conformance with regulations and rules therefore as required in the current manual of survey instructions of the United States Department of the Interior, Bureau of Land Management or by a decree of a Court of Law and /or that the corner points mentioned in lines 3, 4 and 5 above were in conformance with the rules of the Michigan Board of Land Surveyors or by a Decree of a Court of Law; established, re-established, monumented, recovered, found as expressed below:

NOTE: Not more than 2 corners, all in the same town and range, may be recorded on this certificate.

A. Description of original monument and accessories and/or subsequent restoration:

1	A	B	C	D	E	F	G	H	I	J	K	L	M
2		6		5		4		3		2		1	
3													
4		7		8		9		10		11		12	
5													
6		18		17		16		15		14		13	
7													
8		19		20		21		22		23		24	
9													
10		30		29		28		27		26		25	
11													
12		31		32		33		34		35		36	
13													

(K5) Corner common to Sections 11-12-13-14. 1962: Reestablished by Billy D. Buckler RLS by double proportionate measurement between corners 0.5 miles North, 1.5 miles East, 3 miles South, and 2.5 miles West. Set 1" ID Iron pipe with 4" aluminum cap. 9" Jack Pine S68W 17 links, 8" Jack Pine N65E 71 links.

(L5) Quarter corner common to Sections 12-13. 1962: Billy D. Buckler RLS reestablished the corner midway and on line between Section corners. Set 1" pipe with 4" aluminum cap. 16" Jack Pine N4W 73 links, 13" Red Pine N78W 95 links.

B. Description of corner evidence found and/or method applied in restoring or reestablishing corner:


(K5) Recovered the 1962 monument at record bearing and distance from the stump remains of the 1962 NBTs. The 1962 position for this corner is not accepted due to the reestablishment by the undersigned of corner M5 T46N-R14W. I destroyed the 1962 corner position and reinstalled the 1962 monument at a position proportionate to the original record between monumented corners of record 2652.32' North, 13191.41' West, 15911.00' South, and 5335.28' East. The bearing trees from the original 1850 survey by Guy Carleton were not found. From the corner thus established, the 1960 position is S78W 72.79' distant.

(L5) Found the 1962 monument in good condition. The 1962 witnesses were not found. The 1962 position for this corner is not accepted due to the reestablishment by the undersigned of corner M5 T46N-R14W, upon which the proportionate position of the corner depends. I destroyed the 1962 corner position and reinstalled the 1962 monument midway and on a line of mean true bearing between Section corners (both reestablished by the undersigned) 2667.64' East and West. The bearing trees from the original 1850 survey by Guy Carleton, DS were not found. From the corner thus established, the 1962 position is S83W 80.99' distant.

C. Description of monument for corner and accessories established to perpetuate locating the position of the corner:

(K5) Set 1" ID x 36" I. pipe with 4" brass MDNR cap. Blazed, scribed, and set measuring nails in:
 5" J. Pine S21W 7.8' "S14 NBT"
 4" J. Pine N87W 5.75' "S11 NBT"
 5" J. Pine N87E 2.7' "S12 NBT"
 6" J. Pine N56E 7.85' "S12 NBT"
 Set cedar post adjacent. Bearings are magnetic. Distances are to nail with tag.

(L5) Set a 1" ID I. pipe with 4" aluminum MDNR cap. Blazed, scribed, and set measuring nails in:
 10" J. Pine N70E 1.8' "1/4S NBT"
 10" J. Pine N30E 8.3' do
 6" J. Pine N43W 35.55' do
 12" J. Pine S60W 29.5' do
 Bearings are magnetic. Distances are to nail with tag. The center of a trail road is West 11'.

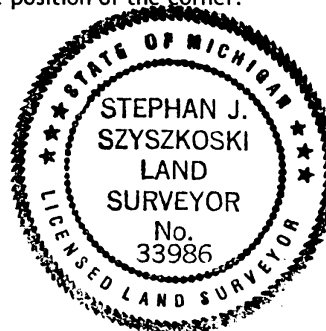

Signed by Stephan J. Szyszkoski
 Surveyor's Michigan License No. 33986

Date 11/18/03

For the Michigan Department of Natural Resources, Office of Land and Facilities