

MICHIGAN
DEPARTMENT OF CONSERVATION
FORESTRY DIVISION

LAND CORNER RECORD

T. 46 N.R. 15 W.

Schoolcraft COUNTY


DESCRIPTION OF CORNER Section Corner common to Sections 13, 14, 23, and 24.

CORNER MONUMENT 1" Pipe with 4" Aluminum Cap.

DATE MONUMENT PLACED AND WITNESSED 6/20/63

WITNESSES TO CORNER..... 9" Jack Pine (S. 23 N.B.T.) S. 22° W. 25 Lks.

9" W. Pine Stub (S. 13 N.B.T.) N. 10° E. 86 Lks.

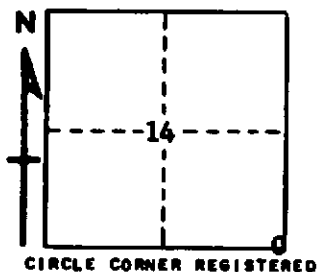

AND

DESCRIPTION IN DETAIL AS TO HOW CORNER WAS LOCATED AND IDENTIFIED OR RESTORED.

This Corner was
Re-established by Double Proportionate measure from
Corners South and West and Streams North and East.

No evidence of Original Corner.

Placed Location Poster North of Corner on Road.

SURVEYOR'S SEAL

SIGNED Billy D. Buckler DATE 7-29-63
REGISTERED LAND SURVEYOR
Billy D. Buckler