LAND CORNER RECORDATION CERTIFICATE
Filing Requirement of Act 74, Mich. P.A. 1970 as Amended

For corners in

Schoolcraft (County)

		Located In:	Corner Code #
1. Public Land Survey		T 46N R 15W	H6
		T 46N R 15W	H5
		T R	
	S	T R	
2. Property Controlling	S	T R	
in Section	S	T R	
3. Miscellaneous	S	T R	
Property in Sec.	S	T R	

Register of Deeds Stamp & File Number

4. Lot No. _____ , Recorded Plat _____

5. Private Claims

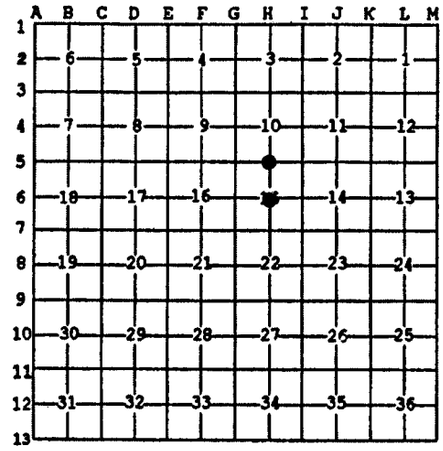

Jul 05 2006

I, Stephan J. Szyszkoski, in a field survey on _____, 20 ___ do hereby state that under requirements of P.A. 74, Michigan P.A. of 1970, the corner points mentioned in lines 1 and 2 above were in conformance with regulations and rules therefore as required in the current manual of survey instructions of the United States Department of the Interior, Bureau of Land Management or by a decree of a Court of Law and /or that the corner points mentioned in lines 3, 4 and 5 above were in conformance with the rules of the Michigan Board of Land Surveyors or by a Decree of a Court of Law; established, re-established, monumented, recovered, found as expressed below:

NOTE: Not more than 2 corners, all in the same town and range, may be recorded on this certificate.

A. Description of original monument and accessories and/or subsequent restoration:

(H6) Center of Section 15. Not established in the original survey. Found no subsequent record.
(H5) Quarter corner common to Sections 10-15. 1850 - Established by Guy Carleton, Deputy Sureyor, midway and on line between Section corners 40.48 chains east and west. Set post. Beech 8 N73E 28 links, Beech 14 S28W 11 links.

B. Description of corner evidence found and/or method applied in restoring or reestablishing corner:

(H6) Established the corner at the intersection of straight lines connecting opposite 1/4 corners.
(H5) The original post and accessories were not recovered. Found no evidence of the position of the original corner on the ground. Reestablished the corner midway and on the Section line between Section corners 2637.68' east and west.

C. Description of monument for corner and accessories established to perpetuate locating the position of the corner:

(H6) Set 1"IDx36" I.pipe with 4" alum. MDNR cap. Set measuring nails in:

7" Maple East 64.75'	mrkd "CS BT"
7" Maple N68W 4.45'	do
6" Maple S53E 17.45'	do
8" Maple S27W 29.15'	do

Bearings are magnetic. Distances are to nail with tag.

(H5) Set 1"IDx36" I.pipe with 4" alum. MDNR cap. Set measuring nails in:

5" Maple S41E 12.55'	mrkd "1/4S NBT"
8" Maple N59W 27.63'	do
7" Maple N69E 21.67'	do
8" Cherry S12W 22.08'	do

Bearings are magnetic. Distances are to nail with tag.

STATE OF MICHIGAN
STEPHAN J. SZYSZKOSKI
LAND SURVEYOR
No. 33986
LICENSED LAND SURVEYOR

Signed by Stephan J. Szyszkoski Date 8/15/06

Surveyor's Michigan License No. 33986

For the Michigan Department of Natural Resources, Office of Land and Facilities

FORM APPROVED BY MICHIGAN STATE BOARD OF PROFESSIONAL SURVEYORS, JAN. 28, 1971
Revised May 14, 1975
Revised Jan., 1983
Revised Oct., 1995