LAND CORNER RECORDATION CERTIFICATE
Filing Requirement of Act 74, Mich. P.A. 1970 as Amended

For corners in

Schoolcraft
(County)

		Located In:	Corner Code #
1. Public Land Survey		T 46N R 15W	H7
		T 46N R 15W	J7
		T___ R___	
	S___	T___ R___	
2. Property Controlling	S___	T___ R___	
in Section	S___	T___ R___	
3. Miscellaneous	S___	T___ R___	
Property in Sec.	S___	T___ R___	

Register of Deeds Stamp & File Number

4. Lot No. _____ , Recorded Plat_____

5. Private Claims

J7 May 09 2006
H7 May 23 2006

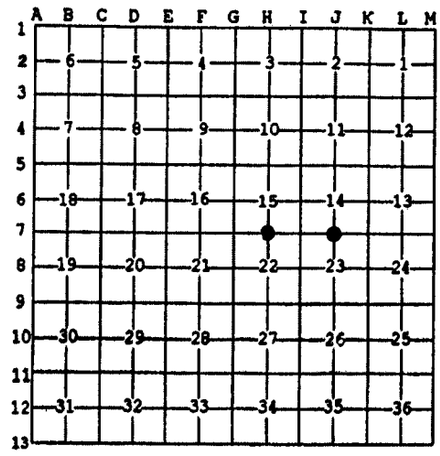

I, Stephan J. Szyszkoski, in a field survey on _____, 20 ___ do hereby state that under requirements of P.A. 74, Michigan P.A. of 1970, the corner points mentioned in lines 1 and 2 above were in conformance with regulations and rules therefore as required in the current manual of survey instructions of the United States Department of the Interior, Bureau of Land Management or by a decree of a Court of Law and /or that the corner points mentioned in lines 3, 4 and 5 above were in conformance with the rules of the Michigan Board of Land Surveyors or by a Decree of a Court of Law; established, re-established, monumented, recovered, found as expressed below:

NOTE: Not more than 2 corners, all in the same town and range, may be recorded on this certificate.

A. Description of original monument and accessories and/or subsequent restoration:

(H7) Quarter corner common to Sections 15-22. 1960 - Reestablished by single proportionate measurement to the original record by Billy D. Buckler RLS. Set 1" pipe with 4" brass cap. 14" Hemlock N53W 25 links, 12" Y.Birch S77E 25 links.
(J7) Quarter corner common to Sections 14-23. 1960 - Remonumented in the original position by Billy D. Buckler RLS, who found two Hemlock BTs, down and in poor condition, with iron marks visible. Set 1" pipe with 4" brass cap. 7" Y.Birch S51E 21 links, 9" Y.Birch N49E 48 links.

B. Description of corner evidence found and/or method applied in restoring or reestablishing corner:

(H7) The 1960 monument was recovered in good condition and at record bearing and distance from the NBTs. The Hemlock is in good condition, the Y.Birch has been cut. Left the monument in place and made new witnesses.
(J7) Recovered the 1960 monument in good condition and at record bearing and distance from the 1960 witnesses. The Y.Birch SE is in good condition. The Y.Birch NE is standing dead. The Hemlock BTs were not recovered. Left the monument in place and made new witnesses.

C. Description of monument for corner and accessories established to perpetuate locating the position of the corner:

(H7) Fd. 1"ID I.pipe with 4" brass MI Dept. of Conservation cap. Set measuring nails in:
17" Hemlock N52W 16.86' mrkd "1/4S" *
8" Maple N02E 7.9' "1/4S NBT"
15" Maple S30W 10.93' do
6" twin Maple S48E 16.7' do
Bearings are magnetic. Distances are to nail with tag. * denotes 1960 NBT.

(J7) Fd. 1"ID I.pipe with 4" brass MI Dept. of Conservation cap. Set measuring nails in:
14" Y.Birch S49E 14.57' mrkd "1/4S" *
10" Hemlock S58E 35.55' "1/4S NBT"
14" Y.Birch N03W 63.15' do
6" Hemlock S67W 13.55' do
Bearings are magnetic. Distances are to nail with tag. * denotes 1960 NBT.

STATE OF MICHIGAN
STEPHAN J. SZYSZKOSKI
LAND SURVEYOR
No. 33986
LICENSED LAND SURVEYOR

Signed by Stephan J. Szyszkoski Date 8/15/06

Surveyor's Michigan License No. 33986

For the Michigan Department of Natural Resources, Office of Land and Facilities

FORM APPROVED BY MICHIGAN STATE BOARD OF PROFESSIONAL SURVEYORS, JAN. 28, 1971
Revised May 14, 1975
Revised Jan., 1983
Revised Oct., 1995