LAND CORNER RECORDATION CERTIFICATE
Filing Requirement of Act 74, Mich. P.A. 1970 as Amended

For corners in

Schoolcraft (County)

		Located In:		Corner Code #
1. Public Land Survey		T 46N	R 15W	I3
		T	R	
		T	R	
	S	T	R	
2. Property Controlling	S 10	T 46N	R 15W	7
in Section	S	T	R	
3. Miscellaneous	S	T	R	
Property in Sec.	S	T	R	

Register of Deeds Stamp & File Number

4. Lot No. _____ , Recorded Plat _____

5. Private Claims

I3 Mar 14 2006
7 Mar 16 2006

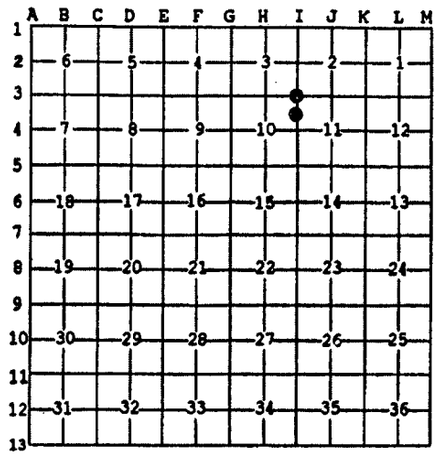

I, Stephan J. Szyszkoski, in a field survey on _____, 20 ____ do hereby state that under requirements of P.A. 74, Michigan P.A. of 1970, the corner points mentioned in lines 1 and 2 above were in conformance with regulations and rules therefore as required in the current manual of survey instructions of the United States Department of the Interior, Bureau of Land Management or by a decree of a Court of Law and /or that the corner points mentioned in lines 3, 4 and 5 above were in conformance with the rules of the Michigan Board of Land Surveyors or by a Decree of a Court of Law; established, re-established, monumented, recovered, found as expressed below:

NOTE: Not more than 2 corners, all in the same town and range, may be recorded on this certificate.

A. Description of original monument and accessories and/or subsequent restoration:

(I3) Corner common to Sections 2-3-10-11. 1850 - Established by Guy Carleton, Deputy Surveyor. Set post. Spruce 8 SW 116 links, Spruce 10 N79W 131 links. Found no subsequent record.
(7-Sec. 10) North 1/16 corner between Sections 10 and 11. Not established in the original survey. Found no subsequent record.

B. Description of corner evidence found and/or method applied in restoring or reestablishing corner:

(I3) The original post and accessories were not recovered. Found no evidence of the position of the original corner on the ground. Reestablished the corner by double proportionate measurement to the original record between Section corner 5304.98' west (US record 80.84 chains), Quarter corner 2655.41' east (US record 40.465 chains), Section corner 5296.06 south (US record 80.84 chains), and Quarter corner 2647.99' north (US record 40.42 chains).
(7-Sec. 10) Established the corner midway and on the Section line between Section corner 1324.01' north and Quarter corner 1324.01' south.

C. Description of monument for corner and accessories established to perpetuate locating the position of the corner:

(I3) Set 1"IDx36" I.pipe with 4" alum. MDNR cap. Set measuring nails in:
10" W.Pine N85W 310.16' mrkd "S3 NBT"
12" W.Pine S16W 498.19' "S10 NBT"
14" W.Pine N72E 308.83' "S2 NBT"
19" W.Pine S74E 462.00 "S11 NBT"
Bearings are magnetic. Distances are to nail with tag.

(7) Set 1"IDx36" I.pipe with 4" alum. MDNR cap. Set measuring nails in:
6" W.Pine N66W 7.25' mrkd "N1/16 BT"
7" W.Pine S84W 31.35' do
7" W.Pine S64W 29.9' do
6" W.Pine N09E 22.85' do
Bearings are magnetic. Distances are to nail with tag.

STATE OF MICHIGAN
STEPHAN J. SZYSZKOSKI
LAND SURVEYOR
No. 33986
LICENSED LAND SURVEYOR

Signed by Stephan J. Szyszkoski Date 8/15/06

Surveyor's Michigan License No. 33986

For the Michigan Department of Natural Resources, Office of Land and Facilities

FORM APPROVED BY MICHIGAN STATE BOARD OF PROFESSIONAL SURVEYORS, JAN. 28, 1971
Revised May 14, 1975
Revised Jan., 1983
Revised Oct., 1995