

**LAND CORNER RECORDATION CERTIFICATE**  
**Filing Requirement of Act 74, Mich. P.A. 1970 as Amended**

For corners in

<u>Schoolcraft</u> (County)	Located In:	Corner Code #
1. Public Land Survey	T <u>46N</u> R <u>15W</u>	<u>15</u>
	T <u>46N</u> R <u>15W</u>	<u>K3</u>
	T _____ R _____	_____
	S _____ T _____ R _____	_____
2. Property Controlling in Section	S _____ T _____ R _____	_____
	S _____ T _____ R _____	_____
3. Miscellaneous Property in Sec.	S _____ T _____ R _____	_____

Register of Deeds Stamp & File Number

4. Lot No. \_\_\_\_\_, Recorded Plat \_\_\_\_\_  
 5. Private Claims

	K3 Jun 12 2006	
	15 Mar 20 2006	

1	A	B	C	D	E	F	G	H	I	J	K	L	M
2		6		5		4		3		2		1	
3											●		
4		7		8		9		10		11		12	
5									●				
6		18		17		16		15		14		13	
7													
8		19		20		21		22		23		24	
9													
10		30		29		28		27		26		25	
11													
12		31		32		33		34		35		36	
13													

I, Stephan J. Szyszkoski, in a field survey on \_\_\_\_\_, 20\_\_\_\_ do hereby state that under requirements of P.A. 74, Michigan P.A. of 1970, the corner points mentioned in lines 1 and 2 above were in conformance with regulations and rules therefore as required in the current manual of survey instructions of the United States Department of the Interior, Bureau of Land Management or by a decree of a Court of Law and /or that the corner points mentioned in lines 3, 4 and 5 above were in conformance with the rules of the Michigan Board of Land Surveyors or by a Decree of a Court of Law; established, re-established, monumented, recovered, found as expressed below:

**NOTE: Not more than 2 corners, all in the same town and range, may be recorded on this certificate.**

A. Description of original monument and accessories and/or subsequent restoration:


- (I5) Corner common to Sections 10-11-14-15. 1954 - Corner remonumented by Michigan Dept. of Conservation surveyors from an original B.T. Beech, in good condition. Set 1" pipe with 4" brass cap. 12" Beech S70W 59 links, 12" Beech S18E 83 links.
- (K3) Corner common to Sections 1-2-11-12. 1976 - Recorded by Herbert Fluharty RLS: Fd. 1" pipe with alum. cap 32' +/- East of woods road. 9" W.Pine N60W 15.25', 7" Maple S08E 8.35', 6" Maple N47E 31.88'. See LCRC Liber 1 Page 145, Schoolcraft Co. LCR. Found no other record.

B. Description of corner evidence found and/or method applied in restoring or reestablishing corner:

- (I5) The 1954 monument was not recovered. Found a 1/2" rebar laying on the ground near the corner position. Recovered a 1" dia. hole in the ground, presumably marking the position of the 1954 monument, at record bearing and distance from the 1954 witness trees. The Beech SW is in good condition, the Beech SE is a cut stump. Also found the original Beech BT S2W 13.86', the top broken off and DBH blaze rotted out. Placed a new monument in the hole and in accord with the record witnesses.
- (K3) Recovered a 1" ID I.pipe with 4" alum. MI Dept. of Conservation cap, of which I could find no record of monumentation, in good condition and at record bearing and distance from the 1976 witness trees, all in place. Also recovered a Hemlock NBT NE, apparently marked by the MI Dept. of Conservation, of which there is no record. Accepted the monument as found.

C. Description of monument for corner and accessories established to perpetuate locating the position of the corner:

- |   |   |
|---|---|
| (I5) Set 1" IDx36" I.pipe with 4" alum. MDNR cap. Set measuring nails in:<br>6" Maple N23W 23.95'    mrkd "S10 NBT"<br>18" Cherry N66E 35.95'    "S11 NBT"<br>8" Maple S77E 18.5'        "S14 NBT"<br>18" Beech S68W 38.95'      "S15 NBT"*<br>Bearings are magnetic. Distances are to nail with tag. * denotes 1954 NBT. | (K3) Fd. 1" ID I.pipe with 4" aluminum cap. Set measuring nails in:<br>11" W.Pine N60W 15.43'       *<br>14" Hemlock N39E 50.18'     *<br>6" Maple S32E 16.05'       mrkd "S12 NBT"<br>5" Balsam S53W 17.25'       "S11 NBT"<br>Bearings are magnetic. Distances are to nail with tag. * denotes 1976 NBTs. |
|---|---|

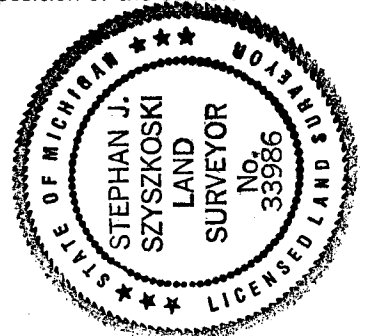

Signed by Stephan J. Szyszkoski  
 Surveyor's Michigan License No. 33986

Date 1/22/07