

LAND CORNER RECORDATION CERTIFICATE
Filing Requirement of Act 74, Mich. P.A. 1970 as Amended

For corners in

<u>Schoolcraft</u> (County)	Located In:	Corner Code #
1. Public Land Survey	T46N R 15W	I9
	T R	
	T R	
2. Property Controlling in Section	S T R	
	S T R	
3. Miscellaneous Property in Sec.	S T R	
	S T R	

Register of Deeds Stamp & File
Number

4. Lot No. _____, Recorded Plat _____
 5. Private Claims

I, Stephan J. Szyszkoski, in a field survey on March 7, 2007 do hereby state that under requirements of P.A. 74, Michigan P.A. of 1970, the corner points mentioned in lines 1 and 2 above were in conformance with regulations and rules therefore as required in the current manual of survey instructions of the United States Department of the Interior, Bureau of Land Management or by a decree of a Court of Law and /or that the corner points mentioned in lines 3, 4 and 5 above were in conformance with the rules of the Michigan Board of Land Surveyors or by a Decree of a Court of Law; established, re-established, monumented, recovered, found as expressed below:


NOTE: Not more than 2 corners, all in the same town and range, may be recorded on this certificate.

	A	B	C	D	E	F	G	H	I	J	K	L	M
1													
2	6	5	4	3	2	1							
3													
4	7	8	9	10	11	12							
5													
6	18	17	16	15	14	13							
7													
8	19	20	21	22	23	24							
9													
10	30	29	28	27	26	25							
11													
12	31	32	33	34	35	36							
13													

A. Description of original monument and accessories and/or subsequent restoration:
 (I9) Corner common to Sections 22-23-26-27. 1850 - Established by Guy Carleton, Deputy Surveyor. Set post. Tamarack 14 S48W 14 links, Tamarack 6 S14E 27 links. 1960 - Remonumented by Billy D. Buckler RLS at the position of a post point found at record bearing and distance from the remains of the two Tamarack BTs, one with iron marks visible, the other badly burned. Set 1" pipe with 4" brass cap. 9" Maple N30W 97.5 links, 5" Cedar N84E 63.5 links, 4" W.Birch S48W 12 links.

B. Description of corner evidence found and/or method applied in restoring or reestablishing corner:
 (I9) Found the 1960 monument in good condition and at record bearing and distance from the Cedar NBT NE, in good condition. The other NBTs were not observed. Their remains may yet be present but obscured by deep snow, as would be any remains of the original BTs. Accepted the monument as a careful and faithful perpetuation of the position of the original corner.

C. Description of monument for corner and accessories established to perpetuate locating the position of the corner:
 (I9) Found 1" ID I.pipe with 4" brass State of Michigan cap. Set measuring nails with MDNR tags in the sides of the following trees:
 6" Cedar N86E 42.2' open blazes (1960 NBT)
 5" Cedar N55W 24.75' mrkd "S22 NBT"
 9" Tamarack S65W 23.15' "S27 NBT"
 12" Tamarack S20W 61.0' do
 Bearings are magnetic.

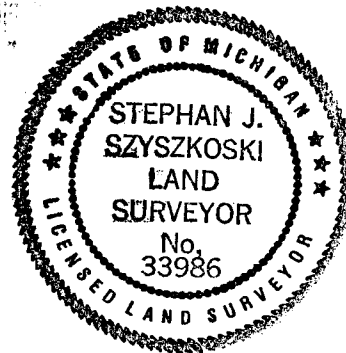

Signed by Stephan J. Szyszkoski Date 10/10/07

Surveyor's Michigan License No. 33986