

**LAND CORNER RECORDATION CERTIFICATE**  
**Filing Requirement of Act 74, Mich. P.A. 1970 as Amended**

For corners in

<u>Schoolcraft</u> (County)	Located In:	Corner Code #
1. Public Land Survey	T <u>46N</u> R <u>15W</u>	<u>J5</u>
	T _____ R _____	_____
	T _____ R _____	_____
	S _____ T _____ R _____	_____
2. Property Controlling in Section	S <u>3</u> T <u>46N</u> R <u>15W</u>	<u>14</u>
	S _____ T _____ R _____	_____
3. Miscellaneous Property in Sec.	S _____ T _____ R _____	_____
	S _____ T _____ R _____	_____

Register of Deeds Stamp & File Number

4. Lot No. \_\_\_\_\_, Recorded Plat \_\_\_\_\_  
 5. Private Claims

J5 Mar 21 2006  
 14 Mar 14 2006

I, Stephan J. Szyszkoski, in a field survey on \_\_\_\_\_, 20\_\_\_\_ do hereby state that under requirements of P.A. 74, Michigan P.A. of 1970, the corner points mentioned in lines 1 and 2 above were in conformance with regulations and rules therefore as required in the current manual of survey instructions of the United States Department of the Interior, Bureau of Land Management or by a decree of a Court of Law and /or that the corner points mentioned in lines 3, 4 and 5 above were in conformance with the rules of the Michigan Board of Land Surveyors or by a Decree of a Court of Law; established, re-established, monumented, recovered, found as expressed below:

**NOTE: Not more than 2 corners, all in the same town and range, may be recorded on this certificate.**

A. Description of original monument and accessories and/or subsequent restoration:


(J5) Quarter corner common to Sections 11-14. 1963 - Reestablished by Billy D. Buckler midway and on line between Section corners. Set 1" Iron pipe with 4" aluminum cap. 22" W.Pine N72W 28 links, 5" Spruce S48E 15 links.  
 (14-Sec. 3) South 1/16 corner between Sections 2 and 3. Not established in the original survey. Found no subsequent record.

B. Description of corner evidence found and/or method applied in restoring or reestablishing corner:

(J5) Recovered the 1963 monument in good condition and at record bearing and distance from the 1963 witnesses. The W.Pine NW is in good condition and the Spruce SE is dead and down. My measurements show this monument is 1.28' from the proportionate position intended in 1963. I accept the monument as a careful and faithful reestablishment of the position of the original corner.  
 (14-Sec. 3) Established the corner midway and on the Section line between Section corner 1323.99' South and Quarter corner 1323.99' North.

C. Description of monument for corner and accessories established to perpetuate locating the position of the corner:

(J5) Fd. 1" ID I.pipe with 4" MI Dept of Conservation cap. Set measuring nails in:	(14) Set 1" IDx36" I.pipe with 4" alum. MDNR cap. Set measuring nails in:
9" Cedar N61E 62.35' mrkd "1/4S NBT"	18" W.Pine N47W 142.72' mrkd "S1/16 BT"
26" W.Pine N68W 19.15' "1/4S" *	18" W.Pine N50E 79.78' do
6" B.Spruce S38W 17.3' mrkd "1/4S NBT"	7" W.Pine N72E 62.18' do
9" W.Pine N19W 32.55' do	23" W.Pine S14E 129.74' do
Bearings are magnetic. Distances are to nail with tag. * denotes 1963 NBT.	Bearings are magnetic. Distances are to nail with tag.

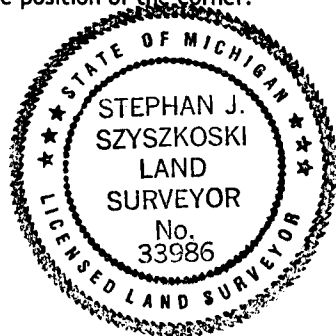

Signed by Stephan J. Szyszkoski  
 Surveyor's Michigan License No. 33986

Date 8/15/06