LAND CORNER RECORDATION CERTIFICATE
Filing Requirement of Act 74, Mich. P.A. 1970 as Amended

For corners in

Schoolcraft
(County)

		Located In:	Corner Code #
1. Public Land Survey		T 46N R 15W	K5
		T 46N R 15W	K7
		T___ R___	
	S___	T___ R___	
2. Property Controlling	S___	T___ R___	
in Section	S___	T___ R___	
3. Miscellaneous	S___	T___ R___	
Property in Sec.	S___	T___ R___	

Register of Deeds Stamp & File Number

4. Lot No. _____ , Recorded Plat_____
5. Private Claims

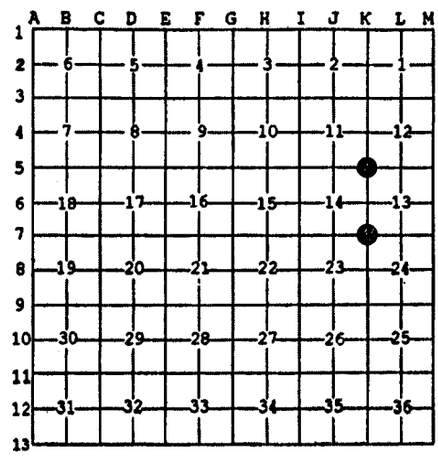

Apr 19 2006

I, Stephan J. Szyszkoski, in a field survey on _____, 20 ____ do hereby state that under requirements of P.A. 74, Michigan P.A. of 1970, the corner points mentioned in lines 1 and 2 above were in conformance with regulations and rules therefore as required in the current manual of survey instructions of the United States Department of the Interior, Bureau of Land Management or by a decree of a Court of Law and /or that the corner points mentioned in lines 3, 4 and 5 above were in conformance with the rules of the Michigan Board of Land Surveyors or by a Decree of a Court of Law; established, re-established, monumented, recovered, found as expressed below:

NOTE: Not more than 2 corners, all in the same town and range, may be recorded on this certificate.

A. Description of original monument and accessories and/or subsequent restoration:

(K5) Corner common to Sections 11-12-13-14. 1963 - Reestablished by Billy D. Buckler RLS by proportioned distance East and West and facing old blazes on a nearby down Tamarack. Set 1" pipe with 4" aluminum cap. 6" W.Pine N38E 16 links, 18" W.Pine S65W 79 links.
(K7) Corner common to Sections 13-14-23-24. 1963 - Reestablished by double proportionate measurement by Billy D. Buckler RLS, between corners south and west and streams north and east. Set 1" pipe with 4" aluminum cap. 9" J.Pine S22W 25 links, 9" W.Pine stub N10E 86 links.

B. Description of corner evidence found and/or method applied in restoring or reestablishing corner:

(K5) Recovered the 1963 monument in good condition and at record bearing and distance from the 1963 NBTs. The W.Pine NE is in good condition. The W.Pine SW is standing dead. The corner lies about 100' west of a NW-SE road.
(K7) Recovered the 1963 monument in good condition and at record bearing and distance from the 1963 NBTs. The J.Pine is dead and down, the W.Pine stub is a stump with only the notch showing. Left the monument in place and made new witnesses.

C. Description of monument for corner and accessories established to perpetuate locating the position of the corner:

(K5) Fd. 1"ID I.pipe with 4" alum. MI Dept. of Conservation cap. Set measuring nails in:
19" W.Pine N46E 10.5' mrkd "S12" *
19" W.Pine S52E 61.1' mrkd "S13 NBT"
10" W.Pine N25W 14.25' "S11 NBT"
9" W.Pine N80E 36.0' "S12 NBT"
Bearings are magnetic. Distances are to nail with tag. * denotes 1963 NBT.

(K7) Fd. 1" ID I.pipe with 4" alum. MI Dept. of Conservation cap. Set measuring nails in:
6" J.Pine N62E 2.25' mrkd "S13 NBT"
5" J.Pine N21W 8.6' "S14 NBT"
5" J.Pine S83W 8.85' "S23 NBT"
6" Tamarack S39E 16.75' "S24 NBT"
Bearings are magnetic. Distances are to nail with tag.

STATE OF MICHIGAN
STEPHAN J. SZYSZKOSKI
LAND SURVEYOR
No. 33986
LICENSED LAND SURVEYOR

Signed by Stephan J. Szyszkoski Date 8/14/06

Surveyor's Michigan License No. 33986

For the Michigan Department of Natural Resources, Office of Land and Facilities

FORM APPROVED BY MICHIGAN STATE BOARD OF PROFESSIONAL SURVEYORS, JAN. 28, 1971
Revised May 14, 1975
Revised Jan., 1983
Revised Oct., 1995