

**LAND CORNER RECORDATION CERTIFICATE**  
**Filing Requirement of Act 74, Mich. P.A. 1970 as Amended**

For corners in

<u>Schoolcraft</u> (County)	Located In:	Corner Code #
1. Public Land Survey	T ___ R ___	_____
	T ___ R ___	_____
	T ___ R ___	_____
2. Property Controlling in Section	S ___ T ___ R ___	_____
	S 3 T 46N R 15W	4
	S 10 T 46N R 15W	2
3. Miscellaneous Property in Sec.	S ___ T ___ R ___	_____
	S ___ T ___ R ___	_____

Register of Deeds Stamp & File Number

4. Lot No. \_\_\_\_\_, Recorded Plat \_\_\_\_\_  
 5. Private Claims

2 Mar 16 2006  
 4 Mar 15 2006

1	A	B	C	D	E	F	G	H	I	J	K	L	M
2		6		5		4		3		2		1	
3													
4		7		8		9		10		11		12	
5													
6		18		17		16		15		14		13	
7													
8		19		20		21		22		23		24	
9													
10		30		29		28		27		26		25	
11													
12		31		32		33		34		35		36	
13													

I, Stephan J. Szyszkoski, in a field survey on \_\_\_\_\_, 20\_\_ do hereby state that under requirements of P.A. 74, Michigan P.A. of 1970, the corner points mentioned in lines 1 and 2 above were in conformance with regulations and rules therefore as required in the current manual of survey instructions of the United States Department of the Interior, Bureau of Land Management or by a decree of a Court of Law and /or that the corner points mentioned in lines 3, 4 and 5 above were in conformance with the rules of the Michigan Board of Land Surveyors or by a Decree of a Court of Law; established, re-established, monumented, recovered, found as expressed below:

NOTE: Not more than 2 corners, all in the same town and range, may be recorded on this certificate.

A. Description of original monument and accessories and/or subsequent restoration:


- (4-Sec. 3) Northwest 1/16 corner, Section 3. Not established in the original survey. Found no subsequent record.
- (2-Sec. 10) East 1/16 corner between Sections 3 and 10. Not established in the original survey. Found no subsequent record.

B. Description of corner evidence found and/or method applied in restoring or reestablishing corner:

- (4-Sec. 3) Established the corner at the intersection of straight lines connecting opposite 1/16 corners. The monument placed leans slightly SW due to large roots. The center of the cap marks the corner position.
- (2-Sec. 10) Established the corner midway and on the Section line between Section corner 1326.24' East and Quarter corner 1326.24' West.

C. Description of monument for corner and accessories established to perpetuate locating the position of the corner:

- |  |   |
|--|---|
| (4) Set 1"IDx36" I.pipe with 4" alum.<br>MDNR cap. Set measuring nails in:<br>6" Maple S24W 34.75' mrkd "NW1/16 8T"<br>5" triple Hemlock N71E 27.6' do<br>12" Hemlock N29W 11.95' do<br>5" Hemlock S54W 28.9' do<br>Bearings are magnetic. Distances are to nail with tag. | (2) Set 1"IDx36" I.pipe with 4" alum.<br>MDNR cap. Set measuring nails in:<br>8" Cedar N52E 71.55' mrkd "E1/16 8T"<br>21" W.Pine N72W 45.65' do<br>6" W.Pine S45W 35.05' do<br>7" W.Pine S22E 14.51' do<br>Bearings are magnetic. Distances are to nail with tag. |
|--|---|

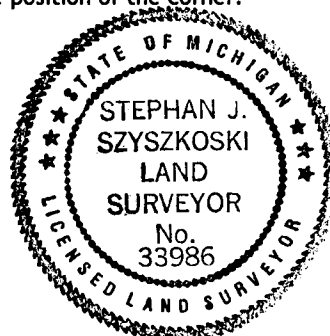

Signed by Stephan J. Szyszkoski  
 Surveyor's Michigan License No. 33986

Date 8/15/06