

**LAND CORNER RECORDATION CERTIFICATE**  
**Filing Requirement of Act 74, Mich. P.A. 1970 as Amended**

For corners in

<u>Schoolcraft</u> (County)	Located In:	Corner Code #
1. Public Land Survey	T ___ R ___	_____
	T ___ R ___	_____
	T ___ R ___	_____
	S <u>28</u> T <u>46N</u> R <u>15W</u>	<u>13</u>
2. Property Controlling in Section	S <u>28</u> T <u>46N</u> R <u>15W</u>	<u>14</u>
	S ___ T ___ R ___	_____
3. Miscellaneous Property in Sec.	S ___ T ___ R ___	_____
	S ___ T ___ R ___	_____
4. Lot No. _____, Recorded Plat _____		
5. Private Claims		

Register of Deeds Stamp & File Number

1	A	B	C	D	E	F	G	H	I	J	K	L	M
2		6		5		4		3		2		1	
3													
4		7		8		9		10		11		12	
5													
6		18		17		16		15		14		13	
7													
8		19		20		21		22		23		24	
9													
10		30		29		28		27		26		25	
11													
12		31		32		33		34		35		36	
13													


I, Stephan J. Szyszkoski, in a field survey on \_\_\_\_\_, 20\_\_\_\_ do hereby state that under requirements of P.A. 74, Michigan P.A. of 1970, the corner points mentioned in lines 1 and 2 above were in conformance with regulations and rules therefore as required in the current manual of survey instructions of the United States Department of the Interior, Bureau of Land Management or by a decree of a Court of Law and /or that the corner points mentioned in lines 3, 4 and 5 above were in conformance with the rules of the Michigan Board of Land Surveyors or by a Decree of a Court of Law; established, re-established, monumented, recovered, found as expressed below:

**NOTE: Not more than 2 corners, all in the same town and range, may be recorded on this certificate.**

- A. Description of original monument and accessories and/or subsequent restoration:  
 (13-Sec. 28) Southeast 1/16 corner, Section 28. Not established in the original survey.  
 (14-Sec. 28) South 1/16 corner common to Sections 27 and 28. Not established in the original survey.

- B. Description of corner evidence found and/or method applied in restoring or reestablishing corner:  
 (13-Sec. 28) Established the corner at the intersection of straight lines connecting opposite 1/16 corners.  
 (14-Sec. 28) Established the corner midway and on the Section line between Quarter corner 1325.72' north and Section corner 1325.72' south.

- C. Description of monument for corner and accessories established to perpetuate locating the position of the corner:  
 (13) Set 1"IDx36" I.pipe with 4" alum. MDNR cap. Set measuring nails with MDNR tags in the sides of the following trees:  
 11" W.Birch N15E 18.04' mrkd "SE1/16 BT"  
 4" Balsam S48W 5.33' do  
 5" Spruce S79E 15.49' do  
 6" double Maple S42E 6.02' do  
 Bearings are magnetic.  
 (14) Set 1"IDx36" I.pipe with 4" alum. MDNR cap. Set measuring nails with MDNR tags in the sides of the following trees:  
 14" Tamarack N69E 31.87' mrkd "S1/16 BT"  
 6" Maple S32W 11.05' do  
 7" Cherry N38E 13.48' do  
 10" Maple N62W 16.48' do  
 Bearings are magnetic.

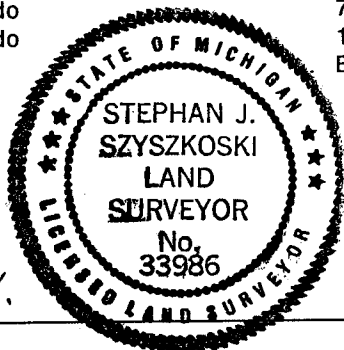

Signed by Stephan J. Szyszkoski Date 10/10/07

Surveyor's Michigan License No. 33986