LAND CORNER RECORDATION CERTIFICATE

Filing Requirement of Act 74, Mich. P.A. 1970 as Amended

For corners in

Schoolcraft (County) Located In: Corner Code #

1. Public Land Survey		T		R		
		T		R		
		T		R		
2. Property Controlling in Section	S 21	T	46N	R	15W	F8
	S 21	T	46N	R	15W	8
	S	T		R		
3. Miscellaneous Property in Sec.	S	T		R		
	S	T		R		

4. Lot No. _____, Recorded Plat _____

5. Private Claims

Register of Deeds Stamp & File Number

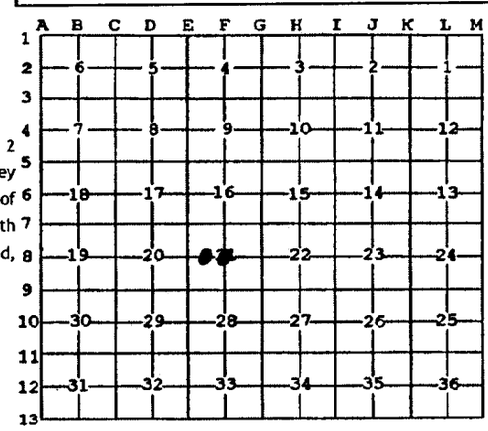

I, Stephan J. Szyszkoski, in a field survey on F8 09/10/2008 8 09/15/2008 do hereby state that under requirements of P.A. 74, Michigan P.A. of 1970, the corner points mentioned in lines 1 and 2 above were in conformance with regulations and rules therefore as required in the current manual of survey instructions of the United States Department of the Interior, Bureau of Land Management or by a decree of a Court of Law and /or that the corner points mentioned in lines 3, 4 and 5 above were in conformance with the rules of the Michigan Board of Land Surveyors or by a Decree of a Court of Law; established, re-established, monumented, recovered, found as expressed below:

NOTE: Not more than 2 corners, all in the same town and range, may be recorded on this certificate.

A. Description of original monument and accessories and/or subsequent restoration:

(F8) Center of Section 21. Not established in the original survey.

(8-Sec. 21) West 1/16 corner, Section 21. Not established in the original survey.

B. Description of corner evidence found and/or method applied in restoring or reestablishing corner:

(F8) Established the corner at the intersection of straight lines connecting opposite 1/4 corners.

(8-Sec. 21) Established the corner midway and on a straight line between Quarter corner 1323.41' west and Center of Section 1323.41' east.

C. Description of monument for corner and accessories established to perpetuate locating the position of the corner:

(F8) Set 1"IDx36" I.pipe with 4" alum. MDNR cap.
Set measuring nail with MDNR tag in the side of:
9" W.Birch N52E 19.97' mrkd "CS BT"
8" Maple S51E 16.49' do
9" Maple N18W 9.92' do
6" Balsam S35W 8.48' do
Bearings are magnetic.

(8) Set 1"IDx36" I.pipe with 4" alum. MDNR cap.
Set measuring nail with MDNR tag in the side of:
6" Spruce N37E 8.33' mrkd "W1/16 BT"
8" Spruce S64E 17.83' do
10" Cedar S73W 30.18' do
6" Spruce N62W 10.44' do
Bearings are magnetic.

Signed by Stephan J. Szyszkoski Date 10/02/2008

Surveyor's Michigan License No. 33986

STATE OF MICHIGAN STEPHAN J. SZYSZKOSKI LAND SURVEYOR No. 33986 LICENSED LAND SURVEYOR

For the Michigan Department of Natural Resources, Office of Land and Facilities

47166

47165

FORM APPROVED BY MICHIGAN STATE BOARD OF PROFESSIONAL SURVEYORS JAN. 26, 1971
Revised May 14, 1975
Revised Jan., 1983
Revised Oct., 1995